

7/27 SURVEY DOCUMENTATION

FEB 14 1997

KENT COUNTY REMONUMENTATION

COMMISSION

LAND CORNER RECORDATION CERTIFICATE  
Filing Requirement of Act 74, Mich. P.A. 1970

For corners in  
KENT COUNTY  
(County)

Located In:	Corner Code #
1. Public Land Survey T8N R11W	F-6
T___ R___	_____
T___ R___	_____
T___ R___	_____
2. Property Controlling in Section S___ T___ R___	_____
S___ T___ R___	_____
3. Miscellaneous Property in Sec. S___ T___ R___	_____
S___ T___ R___	_____

STATE OF MICHIGAN  
COUNTY OF KENT  
RECEIVED FOR RECORD  
96 SEP 13 PM 12:05  
REG. OF DEEDS  
*Lucy Bond*

9357  
Register of Deeds Stamp & File Number

4. Lot No. \_\_\_\_\_, Recorded Plat \_\_\_\_\_  
5. Private Claims \_\_\_\_\_

I, Kirk Breitels, in a field survey on Aug. 23, 1996 do hereby state that under requirements of P.A. 74, Michigan P.A. of 1970, the corner points mentioned in lines 1 and 2 above were in conformance with regulations and rules therefore as required in the current manual of survey instructions of the United States Department of the Interior, Bureau of Land Management or by a decree of a Court of Law and /or that the corner points mentioned in lines 3, 4 and 5 above were in conformance with the rules of the Michigan Board of Land Surveyors or by a Decree of a Court of Law; established, re-established, monumented, recovered, found as expressed below:

	A	B	C	D	E	F	G	H	I	J	K	L	M
1													
2	6		5		4		3		2		1		
3													
4	7		8		9		10		11		12		
5													
6	18		17		16		15		14		13		
7													
8	19		20		21		22		23		24		
9													
10	30		29		28		27		26		25		
11													
12	31		32		33		34		35		36		
13													

NOTE: Not more than 2 corners, all in the same town and range, may be recorded on this certificate.

A. Description of original monument and accessories and/or subsequent restoration:

- F-6 1837---GLO---Not Set
- 1949---Williams & Works---Set Iron at intersection 1/4 lines  
PP SW 41.7' 24" Maple SSE 88.8' 12" Apple SE 58.5'  
On E-W fence 12' E. of N-S fence
- Kent Co. Wit.---Stake & Stone (same witnesses as W & W)
- 1951-70---Williams & Works---Reset C 1/4 at int. 1/4 lines 3.45' N. of previous
- 1978---LCRC #1218---Bonnema---1/2" Solid Rod on E-W fence, 12' W. of N-S fence  
TP SW 42.09' 14" Poplar SSW 20.14' 30" Maple SSE 89.79'
- 1991---Survey---Prien & Newhoff---1/2" Rod per LCRC #1218.

B. Description of corner evidence found and/or method applied in restoring or reestablishing corner:

- F-6 Found 1/2" Solid Iron per the following remaining witnesses:  
Nail in TP SW 42.09' On E-W fence P.A. 345 1990 KENT COUNTY  
C/L 36" Maple SSE 89.7' N-S fence is 12'± EPEER APPROVED 8/22/96  
C/L 30" Poplar SSW 20.1'


CHAIRMAN *Harry Hupner*

Said 1/2" Solid Iron is 0.3' N. and 1.2' E. from intersection of 1/4 lines and agrees with measurements of others.

The 1/2" Solid Iron is accepted by me and is generally accepted by professional surveyors as the best available evidence of the position of the corner.

C. Description of monument for corner and accessories established to perpetuate locating the position of the corner:

- F-6 Set Standard Kent County Monument in place of the 1/2" Solid Iron
- Set Nail & KC Remon. tag NW side 36" Maple S05°E 89.63'
- Set Nail & KC Remon. tag NW side Tel. Pole S50°W 42.19'
- Set Nail & KC Remon. tag SE side 30" Poplar S30°W 20.13'
- Set Nail & KC Remon. tag SE side 15" Maple N35°E 32.99'
- On E-W fence
- N-S fence is 12'± E.

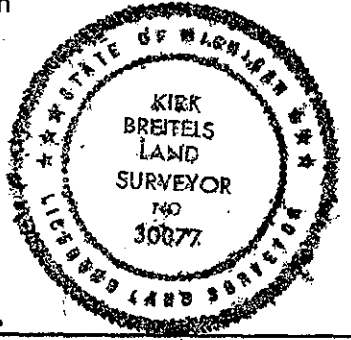

Signed by *Kirk Breitels*  
Surveyor's Michigan License No. 30077

Date 9/4/96