

JAN 24 1996

COMMISSION

LAND CORNER RECORDATION CERTIFICATE
Filing Requirement of Act 74, Mich. P.A. 1970

For corners in

<u>Kent</u> (County)	Located In:	Corner Code #:
1. Public Land Survey	T <u>8N</u> R <u>11W</u>	<u>F-10 Center</u> <u>of Section 28</u>
	T _____ R _____	_____
	T _____ R _____	_____
	T _____ R _____	_____
2. Property Controlling in Section	S _____ T _____ R _____	_____
	S _____ T _____ R _____	_____
3. Miscellaneous Property in Sec.	S _____ T _____ R _____	_____
	S _____ T _____ R _____	_____
4. Lot No. _____, Recorded Plat _____		
5. Private Claims _____		


STATE OF MICHIGAN
COUNTY OF KENT
RECEIVED FOR RECORD

95 OCT 24 PM 4:08

REG. OF DEEDS
W. J. Bond

8716
Register of Deeds Stamp & File Number

I, Wallace E. Glaza in a field survey on October 16, 1995, do hereby certify that under requirements of P.A. 74, Michigan P.A. of 1970, the corner points mentioned in lines 1 and 2 above were in conformance with regulations and rules therefore as required in the current manual of survey instructions of the United States Department of the Interior, Bureau of Land Management or by a decree of a Court of Law and/or that the corner points mentioned in lines 3, 4 and 5 above were in conformance with the rules of the Michigan Board of Land Surveyors or by a Decree of a Court of Law; established, re-established, monumented, re-monumented, recovered, found as expressed below:

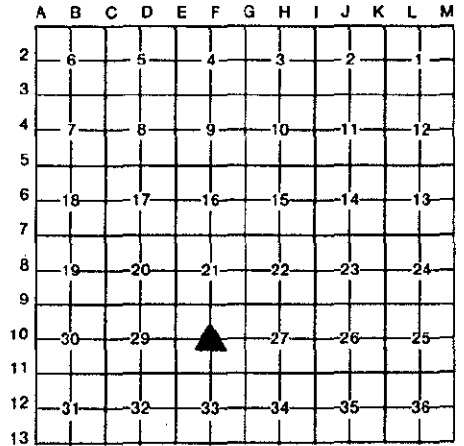

NOTE: Not more than 4 corners, all in the same town and range, may be recorded on this certificate.

A. Description of original monument and accessories and/or subsequent restoration:

- | | | | |
|-------|-----------------------|------------------------------|-------------------------------------|
| F-10 | 1837 | GLO | Not set |
| | 1939 | W.W. | Set iron for center Sec by K.C.R.C. |
| | | | Witnesses: TP NW 49.15' |
| | | | 12" Oak W 20.48' |
| | | | 10" Oak ENE 30.25' |
| 1946- | | | |
| 1958 | W.W. | Used same center as in 1939. | |
| 1980 | LCRC No. 1354 (Exxel) | Found iron | |
| 1980 | LCRC No. 3202 (N & J) | Found "T" iron | |

B. Description of corner evidence found and/or method applied in restoring or reestablishing corner:

F-10 (Center of Section 28, T8N, R11W, Plainfield Township, Kent County, Michigan)

Found "T" iron using witnesses recorded on LCRC No. 3202. The "T" iron has also been used by other surveyors for property surveys and plats.

- 1) Found PK on N side P & T pole WSW 40.29'
- 2) Found PK on E side P. pole NNE 55.5'
- 3) Found plat monument West 42.98'

The "T" iron is accepted by me and is generally accepted by professional surveyors as the best available evidence of the position of the corner.

"T" iron is 2.9' West and 0.7' North of the intersection of the $\frac{1}{4}$ lines.

C. Description of monument for corner and accessories established to perpetuate locating the position of the corner:

F-10 Set 4" x 30" standard Harrison monument in place of "T" iron.

- 1) Found PK nail on N side pole WSW 40.27'
- 2) Set nail & tag on E. side pole N34°E 55.39'
- 3) Found plat monument N90°W 42.95'
- 4) Set nail & tag on S side pole S76°W 40.73'
- 5) SW corner garage S64°E 93.30'
- 6) "X" cut in concrete curb S42°W 63.75'

P.A. 345 1990 KENT COUNTY

PEER APPROVED 6/22/95

CHAIRMAN *[Signature]*

Date 10-23-95

Signed by Wallace E. Glaza
Glaza & Associates, Inc.

Surveyor's Michigan License No. 31592

