

FEB 14 1997

COMMISSION

KENT COUNTY REMONUMENTATION

LAND CORNER RECORDATION CERTIFICATE
Filing Requirement of Act 74, Mich. P.A. 1970

For corners in
KENT COUNTY
(County)

Located In:	Corner Code #
T 8N R 11W	G-3
T R	
T R	
T R	
S T R	
S T R	
S T R	
S T R	

- 1. Public Land Survey
- 2. Property Controlling in Section
- 3. Miscellaneous Property in Sec.

4. Lot No. _____, Recorded Plat _____
5. Private Claims _____


STATE OF MICHIGAN
COUNTY OF KENT
RECEIVED FOR RECORD

96 MAR 20 AM 8:57

REG. OF DEEDS

9066

Register of Deeds Stamp & File Number

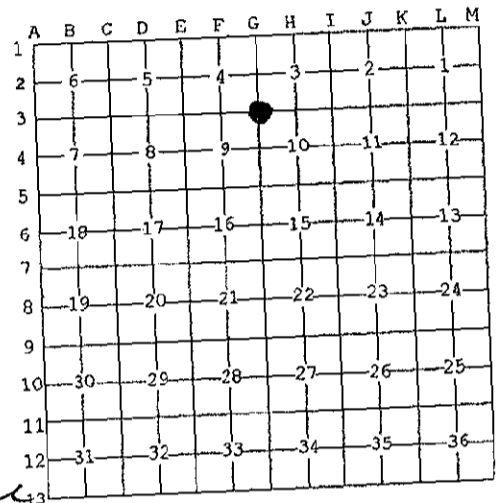

I, **Kirk Breitels**, in a field survey on **Jan. 19, 1996** do hereby state that under requirements of P.A. 74, Michigan P.A. of 1970, the corner points mentioned in lines 1 and 2 above were in conformance with regulations and rules therefore as required in the current manual of survey instructions of the United States Department of the Interior, Bureau of Land Management or by a decree of a Court of Law and/or that the corner points mentioned in lines 3, 4 and 5 above were in conformance with the rules of the Michigan Board of Land Surveyors or by a Decree of a Court of Law; established, re-established, monumented, recovered, found as expressed below:

NOTE: Not more than 2 corners, all in the same town and range, may be recorded on this certificate.

P.A. 345 1990 KENT COUNTY
PEER APPROVED 3/7/96
CHAIRMAN [Signature]

A. Description of original monument and accessories and/or subsequent restoration:

G-3	1837	GLO	Whitcomb	Set Post
		Kent Co. Wit.		Lime Stone
	1975	LCRC #1218 & #3233	Bonnema	Pointed Lime Stone
	1982	LCRC #3449	Jonker	Set Capped Rerod
	1983	LCRC #3527	Stadt	Set Kent County Monument
	1994	LCRC #6934	Byl	Kent County Monument

The position of this corner was previously approved by the Kent County Remonumentation Peer Group, monumented by Russel E. Stadt on 9/7/83 and was recorded per LCRC #3527.

B. Description of corner evidence found and/or method applied in restoring or reestablishing corner:
G-3 Found standard Kent Co. Mon. (Harrison) per witnesses from above LCRC as set by Russel E. Stadt in place of the Capped Rerod over Pointed Limestone he found. Both Iron and Limestone check with Kent Co. Wit. and LCRC's #3233 & #3449.

- LCRC #3527 & #6934
- Nail & KC Remon. tag N. side 24" Oak N85°W 28.64' Nail & KC Remon. tag N. side fence post West 2.25'
 - Nail & KC Remon. tag W. side fence post N10°E 72.25'
 - Nail & KC Remon. tag E. side 12" Walnut S10°W 63.69' Nail & KC Remon. tag E. side 10" Oak S15°W 25.65'
 - Nail & KC Remon. tag N. side 10" Oak S45°W 21.10'
 - Nail & KC Remon. tag S. side 10" Oak S65°W 24.00'

The selected location is accepted by me and is generally accepted by professional surveyors as the best available evidence of the position of the original corner.

C. Description of monument for corner and accessories established to perpetuate locating the position of the corner:
G-3 Standard Kent County Monument

- Nail & KC Remon. tag N. side 30" Oak N85°W 28.64'
- Nail & KC Remon. tag NW side 18" Oak S45°W 21.14'
- New Nail & KC Remon. tag S. side 15" Oak S65°W 24.12'
- Nail & KC Remon. tag E. side 10" Oak S15°W 25.65'
- C/L Asph. Rd. is N'ly 33'± In line with fence West ±
- In tree line South ±



Signed by [Signature]
Surveyor's Michigan License No. 30077

Date 2/6/96