

FEB 14 1997

COMMISSIONER

KENT COUNTY REMONUMENTATION

LAND CORNER RECORDATION CERTIFICATE  
Filing Requirement of Act 74, Mich. P.A. 1970

For corners in

KENT COUNTY

(County)

Located In:

Corner Code #

- |                                    |         |                          |            |
|------------------------------------|---------|--------------------------|------------|
| 1. Public Land Survey              |         | T <u>8N</u> R <u>11W</u> | <u>G-9</u> |
|                                    |         | T _____ R _____          | _____      |
|                                    |         | T _____ R _____          | _____      |
|                                    |         | T _____ R _____          | _____      |
| 2. Property Controlling in Section | S _____ | T _____ R _____          | _____      |
|                                    | S _____ | T _____ R _____          | _____      |
| 3. Miscellaneous Property in Sec.  | S _____ | T _____ R _____          | _____      |
|                                    | S _____ | T _____ R _____          | _____      |

STATE OF MICHIGAN  
COUNTY OF KENT  
RECEIVED FOR RECORD

96 MAR 20 AM 8:57

REG. OF DEEDS

9072

Register of Deeds Stamp & File Number

4. Lot No. \_\_\_\_\_, Recorded Plat \_\_\_\_\_
5. Private Claims \_\_\_\_\_

I, Kirk Breitels, in a field survey on Jan. 24, 19 96 do hereby state that under requirements of P.A. 74, Michigan P.A. of 1970, the corner points mentioned in lines 1 and 2 above were in conformance with regulations and rules therefore as required in the current manual of survey instructions of the United States Department of the Interior, Bureau of Land Management or by a decree of a Court of Law and/or that the corner points mentioned in lines 3, 4 and 5 above were in conformance with the rules of the Michigan Board of Land Surveyors or by a Decree of a Court of Law; established, re-established, monumented, recovered, found as expressed below:

NOTE: Not more than 2 corners, all in the same town and range, may be recorded on this certificate.

P.A. 345 1990 KENT COUNTY

PEER APPROVED 3/7/96

CHAIRMAN Harry Huber

	A	B	C	D	E	F	G	H	I	J	K	L	M
1													
2		6		5		4		3		2		1	
3													
4		7		8		9		10		11		12	
5													
6		18		17		16		15		14		13	
7													
8		19		20		21		22		23		24	
9													
10		30		29		28		27		26		25	
11													
12		31		32		33		34		35		36	
13													

A. Description of original monument and accessories and/or subsequent restoration:

G-9	1831	GLO	Mullett	Set Post
		Kent Co. Wit.		No. desc. - witnesses given
	1983	LCRC #3231	Bonnema	Set Capped Iron holding prev. survey data
	1983	LCRC #3528	Stadt	Set Kent County Monument
	1994	LCRC #6940	Byl	Kent County Monument

The position of this corner was previously approved by the Kent County Remonumentation Peer Group, monumented by Russell E. Stadt on 9/7/83 and was recorded per LCRC #3528.

B. Description of corner evidence found and/or method applied in restoring or reestablishing corner:

G-9 Found standard Kent Co. Mon. (Harrison) per witnesses from above LCRC as set by Russell E. Stadt in place of the Capped Rerod (Exxel) he found. Said Rerod checks with remaining Kent Co. Wit.  $\pm$  and LCRC #3231.

LCRC #3528 & #6940


Nail & KC Remon. tag E. side 12" Maple	N40°W	51.85'	Nail & KC Remon. tag
Nail & KC Remon. tag E. side 10" Maple	N05°W	26.14'	SE side 12" Oak
Nail & KC Remon. tag SE side 16" Oak	N45°E	26.74'	S70°W 52.36'
Nail & KC Remon. tag SW side 12" Oak	S40°E	34.06'	C/L MH S40°E 8.53'
Nail & KC Remon. tag E. side 8" Oak	S20°W	21.04'	

The selected location is accepted by me and is generally accepted by professional

C. Description of monument for corner and accessories established to perpetuate locating the position of the original corner.

G-9 Standard Kent County Monument

Nail & KC Remon. tag E. side 15" Maple	N40°W	51.85'
Nail & KC Remon. tag E. side 12" Maple	N05°W	26.10'
Nail & KC Remon. tag SE side 20" Oak	N45°E	26.68'
Nail & KC Remon. tag SW side 15" Oak	S40°E	34.03'
Nail & KC Remon. tag E. side 10" Oak	S20°W	20.95'
Nail & KC Remon. tag SE side 15" Oak	S70°W	52.35'
C/L Manhole	S40°E	8.53'

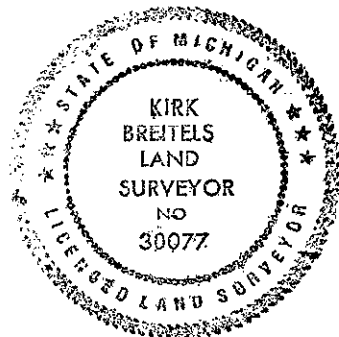

Signed by Kirk Breitels  
Surveyor's Michigan License No. 30077

Date 2/6/96