

FEB 14 1997

COMMISSION

KENT COUNTY REMONUMENTATION

LAND CORNER RECORDATION CERTIFICATE
Filing Requirement of Act 74, Mich. P.A. 1970

For corners in
KENT COUNTY
(County)

Located In:	Corner Code #
1. Public Land Survey	T8N R 11W H-2
	T R
	T R
	T R
2. Property Controlling in Section	S T R
	S T R
3. Miscellaneous Property in Sec.	S T R
	S T R

STATE OF MICHIGAN
COUNTY OF KENT
RECEIVED FOR RECORD
96 SEP 13 PM 12:04
REG. OF DEEDS
Lucy Bond

9349

Register of Deeds Stamp & File Number

4. Lot No. _____, Recorded Plat _____
5. Private Claims _____

	A	B	C	D	E	F	G	H	I	J	K	L	M
1													
2	6	5	4	3	2	1							
3													
4	7	8	9	10	11	12							
5													
6	18	17	16	15	14	13							
7													
8	19	20	21	22	23	24							
9													
10	30	29	28	27	26	25							
11													
12	31	32	33	34	35	36							
13													

I, Kirk Breitels, in a field survey on Aug. 26, 1996 do hereby state that under requirements of P.A. 74, Michigan P.A. of 1970, the corner points mentioned in lines 1 and 2 above were in conformance with regulations and rules therefore as required in the current manual of survey instructions of the United States Department of the Interior, Bureau of Land Management or by a decree of a Court of Law and for that the corner points mentioned in lines 3, 4 and 5 above were in conformance with the rules of the Michigan Board of Land Surveyors or by a Decree of a Court of Law; established, re-established, monumented, recovered, found as expressed below:

NOTE: Not more than 2 corners, all in the same town and range, may be recorded on this certificate.

A. Description of original monument and accessories and/or subsequent restoration:

- H-2 1837---GLO---Not Set
- 1947---Williams & Works---Fence Corner
- 1964---Kent Co. Wit.---Iron: Fence South 9' Fc. Cor. ESE 18'
C.P. NE 61.27' 12" Hick. SE 27.0' 20" Oak SE 36.65'
- 1978---LCRC #1164---Bonnama---1/2" Iron
CP Pole NE 61.27' 12" Hickory SE 27.0'
Wire fence S 9' Old fence cor. ESE 18'
- 1981---Survey---VanKooten---1/2" Iron: CP NE 61.27' 12" Hick. SE 27.0'
- 1992---Survey---W. Glaza---1/2" Iron per LCRC #1164

B. Description of corner evidence found and/or method applied in restoring or reestablishing corner:

- H-2 Found 1/2" Iron Pipe from the following witnesses:
Nail in face of PP NE 61.4'
Face of 20" Hickory SSE 27'
24" Stump SSE 36'±


P.A. 345 1990 KENT COUNTY
PEER APPROVED 8/22/96
CHAIRMAN *Harry Huber*

Said 1/2" Iron Pipe is 0.2' E. and 1.7' N. from intersection of 1/4 lines and agrees with measurements of others.

The 1/2" Iron Pipe is accepted by me and is generally accepted by professional surveyors as the best available evidence of the position of the corner.

C. Description of monument for corner and accessories established to perpetuate locating the position of the corner:

- H-2 Set Standard Kent County Monument in place of the 1/2" Iron Pipe
- Set Nail & KC Remon. tag E. side P. Pole N20°E 62.04'
- Set Nail & KC Remon. tag SW side 20" Hickory S25°E 27.62'
- Set Nail & KC Remon. tag NW side 12" Oak S60°W 36.61'
- Set Nail & KC Remon. tag W. side 6" Beech S00°E 21.84'

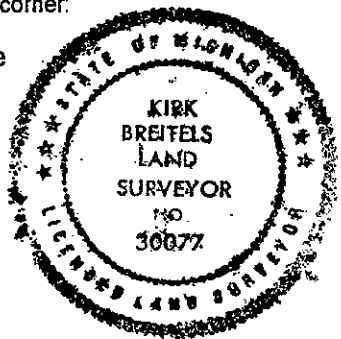

Signed by *Kirk Breitels*
Surveyor's Michigan License No. 30077

Date 9/4/96