

SURVEY & REMONUMENTATION

KENT COUNTY REMONUMENTATION

FEB 14 1997

LAND CORNER RECORDATION CERTIFICATE
Filing Requirement of Act 74, Mich. P.A. 1970

STATE OF MICHIGAN
COUNTY OF KENT
RECEIVED FOR RECORD
96 SEP 13 PM 12:05

REG. OF DEEDS
Lucy Bond

9354

Register of Deeds Stamp & File Number

For corners in
KENT COUNTY
(County)

Located In:	Corner Code #
T 8N R 11W	H-4
T _____ R _____	_____
T _____ R _____	_____
T _____ R _____	_____
S _____ T _____ R _____	_____
S _____ T _____ R _____	_____
S _____ T _____ R _____	_____
S _____ T _____ R _____	_____

- Public Land Survey
- Property Controlling in Section
- Miscellaneous Property in Sec.

4. Lot No. _____, Recorded Plat _____
5. Private Claims _____

I, Kirk Breitels, in a field survey on Aug. 26, 1996 do hereby state that under requirements of P.A. 74, Michigan P.A. of 1970, the corner points mentioned in lines 1 and 2 above were in conformance with regulations and rules therefore as required in the current manual of survey instructions of the United States Department of the Interior, Bureau of Land Management or by a decree of a Court of Law and /or that the corner points mentioned in lines 3, 4 and 5 above were in conformance with the Rules of the Michigan Board of Land Surveyors or by a Decree of a Court of Law; established, re-established, monumented, recovered, found as expressed below:

NOTE: Not more than 2 corners, all in the same town and range, may be recorded on this certificate.

	A	B	C	D	E	F	G	H	I	J	K	L	M
1													
2	6		5		4		3		2		1		
3													
4	7		8		9		10		11		12		
5													
6	18		17		16		15		14		13		
7													
8	19		20		21		22		23		24		
9													
10	30		29		28		27		26		25		
11													
12	31		32		33		34		35		36		
13													

A. Description of original monument and accessories and/or subsequent restoration:

- H-4 1837---GLO---Not Set Kent Co. Wit.---Iron
- 1942-64---Williams & Works---Intersected 1/4 lines & set iron
14" Hickory SE 50.50' T. Pole E 37.80' T. Pole W 18.25'
12" Walnut NNE 89.90' 12" Apple NW 58.70' 8" Oak SSW 86.60'
- 1972---LCRC #288---VanKooten---"T" Iron
28" Hickory SE 50.93' 30" Walnut WSW 133.69' P.A. 345 1990 KENT COUNTY
T. Pole E 76.40' NW cor. hse. ENE 194.25'
- 1985---Survey---All Points---"T" Iron
- 1991---Research---Roosien---Used per LCRC #288

PEER APPROVED 8/22/96
CHAIRMAN [Signature]

B. Description of corner evidence found and/or method applied in restoring or reestablishing corner:


- H-4 Found "T" Iron over 1" Iron Pipe per the following witnesses:
30" Hickory SE 30.9' 30" Walnut WSW 133.7'
NW cor. hse. ENE 194.21'

Said "T" Iron over the 1" Iron Pipe is 0.2' W. and 0.4' S. from intersection of 1/4 lines and agrees with survey measurements of others.

The "T" Iron over the 1" Iron Pipe is accepted by me and is generally accepted by professional surveyors as the best available evidence of the position of the corner.

C. Description of monument for corner and accessories established to perpetuate locating the position of the corner:

- H-4 Set Standard Kent County Monument over the 1" Iron Pipe in place of the "T" Iron
- Set Nail & KC Remon. tag E. side P. Pole S20°E 73.74'
- Set Nail & KC Remon. tag E. side 36" Walnut S15°W 133.68'
- Set Nail & KC Remon. tag N. side 16" Poplar S80°W 33.81'
- Set Nail & KC Remon. tag S. side T. Pole (newer) N85°E 74.42'
- Set Nail & KC Remon. tag SW side 30" Hickory S30°E 50.88'
- NW corner of house N65°E 194.21'
- C/L Packer Dr. to East is South 20'±

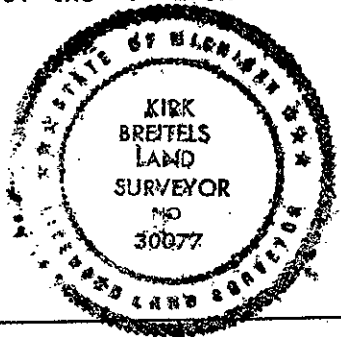

Signed by [Signature]
Surveyor's Michigan License No. 30077

Date 9/4/96