

KENT COUNTY REMONUMENTATION

FEB 14 1997

LAND CORNER RECORDATION CERTIFICATE
Filing Requirement of Act 74, Mich. P.A. 1970

COMMISSION


For corners in KENT COUNTY (County)	Located In:	Corner Code #
1. Public Land Survey	T <u>8N</u> R <u>11W</u>	<u>H-5</u>
	T _____ R _____	_____
	T _____ R _____	_____
	T _____ R _____	_____
2. Property Controlling in Section	S _____ T _____ R _____	_____
	S _____ T _____ R _____	_____
3. Miscellaneous Property in Section	S _____ T _____ R _____	_____
	S _____ T _____ R _____	_____

REG. OF DEEDS
 9189
 Register of Deeds Stamp & File Number

STATE OF MICHIGAN
 COUNTY OF KENT
 RECEIVED FOR RECORD
 96 JUN -7 AM 8:29

4. Lot No. _____, Recorded Plat _____
 5. Private Claims _____

I, Kirk Breitels, in a field survey on Apr. 1, 1996, do hereby certify that under requirements of P.A. 74, Michigan P.A. of 1970, the corner points mentioned in lines 1 and 2 above were in conformance with regulations and rules therefore as required in the current manual of survey instructions of the United States Department of the Interior, Bureau of Land Management or by a decree of a Court of Law and/or that the corner points mentioned in lines 3, 4 and 5 above were in conformance with the rules of the Michigan Board of Professional Surveyors or by a Decree of a Court of Law; established, re-established, monumented, re-monumented, recovered, found as expressed below:

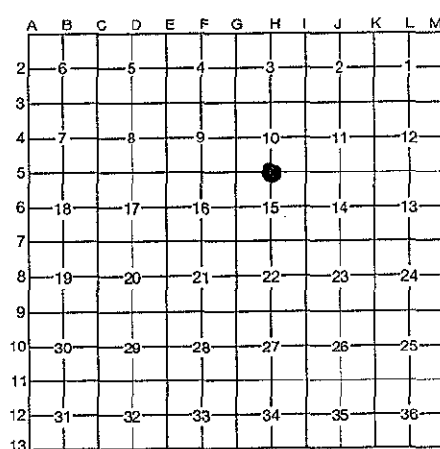

NOTE: Not more than 4 corners, all in the same town and range, may be recorded on this certificate.

A. Description of original monument and accessories and/or subsequent restoration:

H-5	1837	GLO	Whitcomb	Set Post	P.A. 345 1990 KENT COUNTY
	1950	Kent Co. Wit.		3/4" Iron	PEER APPROVED <u>5/30/96</u>
	1957	Consumers Power		Iron	CHAIRMAN <u>[Signature]</u>
	1958	Williams & Works		Iron	
	1983	LCRC #3529	Stadt	Set Kent County Monument	
	1988	LCRC #4846	Bueche	Kent County Monument	

The position of this corner was previously approved by the Kent County Remonumentation Peer Group, monumented by Russel E. Stadt on 9/7/83 and was recorded per LCRC #3529.

B. Description of corner evidence found and/or method applied in restoring or reestablishing corner:

H-5 Found standard Kent Co. Mon. (Harrison) per witnesses from above LCRC as set by Russel E. Stadt in place of the 3/4" Iron he found. Said Iron checks with Kent Co. Wit., Williams & Works and Consumers Power witnesses.

LCRC #3529 & #4846

Nail & KC Remon. tag S. side 28" Oak	N80°E	30.44'
Nail & KC Remon. tag W. side 12" Oak	N50°E	2.70'
Nail & KC Remon. tag W. side 14" Oak	N05°W	24.05'
Nail & KC Remon. tag N. side 30" Oak	N85°W	29.93'
Nail & KC Remon. tag E. side 8" Oak	S10°E	21.78'

In remains of old fence running E & W
 The selected location is accepted by me and is generally accepted by professional surveyors as the best available evidence of the position of the original corner.

C. Description of monument for corner and accessories established to perpetuate locating the position of the corner:

H-5 Standard Kent County Monument

New Nail & KC Remon. tag S. side 28" Oak	N80°E	30.46'
New Nail & KC Remon. tag W. side 12" Oak	N50°E	2.78'
New Nail & KC Remon. tag N. side 30" Oak	N85°W	29.95'
New Nail & KC Remon. tag E. side 8" Oak	S10°E	21.73'
Set Nail & KC Remon. tag W. side 10" Oak	N25°E	43.29'

In remains of old fence running E & W
 Mon. is at SW'ly side of private road to S. & W.



Signed by [Signature] Date 4/26/96
 Surveyor's Michigan License No. 30077