

SURVEY & REMONUMENTATION

FEB 14 1997

COMMISSION

KENT COUNTY REMONUMENTATION

LAND CORNER RECORDATION CERTIFICATE
Filing Requirement of Act 74, Mich. P.A. 1970

For corners in
KENT COUNTY
(County)

Located in:	Corner Code #
T 8N R 11W	H-6
T R	
T R	
T R	
T R	
S T R	
S T R	
S T R	
S T R	

1. Public Land Survey
2. Property Controlling in Section
3. Miscellaneous Property in Sec.

4. Lot No. _____, Recorded Plat _____
5. Private Claims _____

I, Kirk Breitels, in a field survey on Sept. 13, 1996 do hereby state that under requirements of P.A. 74, Michigan P.A. of 1970, the corner points mentioned in lines 1 and 2 above were in conformance with regulations and rules therefore as required in the current manual of survey instructions of the United States Department of the Interior, Bureau of Land Management or by a decree of a Court of Law and/or that the corner points mentioned in lines 3, 4 and 5 above were in conformance with the rules of the Michigan Board of Land Surveyors or by a Decree of a Court of Law, established, re-established, monumented, recovered, found as expressed below:

NOTE: Not more than 2 corners, all in the same town and range, may be recorded on this certificate.

	A	B	C	D	E	F	G	H	I	J	K	L	M
1													
2	6			5				4				3	
3													
4	7												
5													
6	18												
7													
8	19												
9													
10	30												
11													
12	31												
13													

STATE OF MICHIGAN
COUNTY OF KENT
RECEIVED FOR RECORD

96 OCT 18 AM 9:20

REG. OF DEEDS

9406

Register of Deeds Stamp & File Number

A. Description of original monument and accessories and/or subsequent restoration:

- H-6 1837---GLO---Not Set
- 1926-58---Williams & Works---Found/Used Iron on E-W fence, 12.8' N. of true E-W 1/4 line. (7 surveys of numerous parcels).
- 1978---Survey---E. Glaza---Shows N-S 1/4 line - No C 1/4 cor. shown
- 1980---"Rogue River Highlands No. 2"---Exxel---Shows E-W 1/4 Line - No C 1/4 cor.
- 1989---Survey---Byl---Shows N-S 1/4 line - No C 1/4 cor. shown
- 1991---"Shady Lee Plat"---Flanders---Shows N-S 1/4 line straight between N 1/4 cor. and S 1/4 cor. - No C 1/4 cor. shown

B. Description of corner evidence found and/or method applied in restoring or reestablishing corner:

H-6 Found Iron Pipe on remains of old E-W fence in muck area. Said Iron Pipe is 13.2' N. (12.8' W&W) and 7.6' W. of intersection of 1/4 lines. Measurements and angles using this Iron Pipe for the C 1/4 cor. agree with angles and measurements shown on E. Glaza, Byl and numerous Williams & Works surveys ±. Staked occupation along N-S 1/4 line to S 1/4 corner is on line ± using this Iron Pipe for the C 1/4 corner.


The Iron Pipe is accepted by me and is generally accepted by professional surveyors as the best available evidence of the position of the corner.

C. Description of monument for corner and accessories established to perpetuate locating the position of the corner:

- H-6 Set 1/2" Rerod and "Kent County Remon." cap inside 4' long 1" Iron Pipe inside 24" long 1 1/2" Iron Pipe over Iron Pipe found on remains of E-W fence in muck area.
- Set Nail & KC Remon. tag S. side 24" Maple N75°W 42.88'
- Set Nail & KC Remon. tag SW side 12" Poplar N30°W 28.18'
- Set Nail & KC Remon. tag NW side 30" Poplar N50°E 42.42'
- Set Nail & KC Remon. tag W. side 10" Poplar S20°E 78.94'
- C/L E-W foot path is N. 33'±
- N. edge of pond is S. 7'±

Signed by Kirk Breitels
Surveyor's Michigan License No. 30077

Date 10/11/96

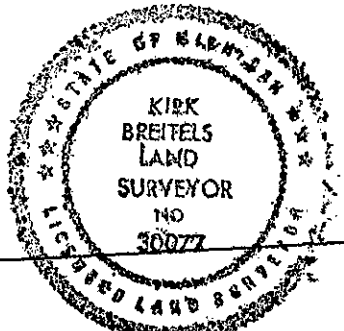

PEER APPROVED 8/22/96
CHAIRMAN Hamp Huber