

FEB 14 1997

KENT COUNTY REMONUMENTATION

COMMISSION LAND CORNER RECORDATION CERTIFICATE
Filing Requirement of Act 74, Mich. P.A. 1970

For corners in

KENT COUNTY

(County)

Located In:

Corner Code #

- | | | |
|------------------------------------|--------------------------|------------|
| 1. Public Land Survey | T <u>8N</u> R <u>11W</u> | <u>H-7</u> |
| | T _____ R _____ | _____ |
| | T _____ R _____ | _____ |
| | T _____ R _____ | _____ |
| 2. Property Controlling in Section | S _____ T _____ R _____ | _____ |
| | S _____ T _____ R _____ | _____ |
| 3. Miscellaneous Property in Sec. | S _____ T _____ R _____ | _____ |
| | S _____ T _____ R _____ | _____ |

STATE OF MICHIGAN
COUNTY OF KENT
RECEIVED FOR RECORD

96 MAR 20 AM 8:57

REG. OF DEEDS

9078

Register of Deeds Stamp & File Number

4. Lot No. _____, Recorded Plat _____
5. Private Claims _____

I, Kirk Breitels, in a field survey on Jan. 29, 19 96 do hereby state that under requirements of P.A. 74, Michigan P.A. of 1970, the corner points mentioned in lines 1 and 2 above were in conformance with regulations and rules therefore as required in the current manual of survey instructions of the United States Department of the Interior, Bureau of Land Management or by a decree of a Court of Law and/or that the corner points mentioned in lines 3, 4 and 5 above were in conformance with the rules of the Michigan Board of Land Surveyors or by a Decree of a Court of Law; established, re-established, monument recovered, found as expressed below:

NOTE: Not more than 2 corners, all in the same town and range, may be recorded on this certificate.

P.A. 345 1990 KENT COUNTY

PEER APPROVED 3/17/96
CHAIRMAN [Signature]

A	B	C	D	E	F	G	H	I	J	K	L	M
1												
2	6	5	4	3	2	1						
3												
4	7	8	9	10	11	12						
5												
6	10	17	16	15	14	13						
7												
8	19	20	21	22	23	24						
9												
10	30	29	28	27	26	25						
11												
12	31	32	33	34	35	36						
13												

A. Description of original monument and accessories and/or subsequent restoration:

H-7	1837	GLO	Whitcomb	Set Post
	1940	Kent Co. Wit.		Mon. Box
	1972	LCRC #184	Spicer	3/4" Iron in Mon. Box
	1981	LCRC #2339	Bueche	Set Kent County Monument in Mon. Box
	1988	LCRC #4847	Bueche	Kent County Monument in Mon. Box

The position of this corner was previously approved by the Kent County Remonumentation Peer Group, monumented by John C. Bueche on 11/2/81 and was recorded per LCRC #2339.

B. Description of corner evidence found and/or method applied in restoring or reestablishing corner:


H-7 Found standard Kent Co. Mon. (Harrison) per witnesses from above LCRC as set by John C. Bueche in place of the 3/4" Iron he found inside a Mon. Box over a Conc. Mon. Both Iron and Conc. Mon. check with Kent Co. Wit. and LCRC #184.

<u>LCRC #2339</u>		<u>LCRC #4847</u>
Nail/tag 20" Oak	N65°E 74.96'	Nail/tag 22" Oak
Nail/tag Guy Pole	S55°E 63.14'	Nail/tag P. Pole
Nail/tag P. Pole	N00°E 46.63'	Nail/tag 16" Elm
NE cor. frame gar.	S55°W 97.78'	C/L top hydr.
		NE cor. frame gar.

The selected location is accepted by me and is generally accepted by professional surveyors as the best available evidence of the position of the original corner.

C. Description of monument for corner and accessories established to perpetuate locating the position of the corner:

H-7 Standard Kent County Monument			
New Nail & KC Remon. tag SE side 24" oak	N65°E	74.91'	
Nail & KC Remon. tag E. side P. Pole	N00°E	46.49'	
New Nail & KC Remon. tag S. side 20" Elm	N55°W	76.72'	
C/L top of fire hydrant	S10°E	53.77'	
NE corner frame garage (Hse. #5985)	S55°W	97.78'	
C/L bit. S. is W. 14'±			
C/L E-W bit. S. 2.5'±			

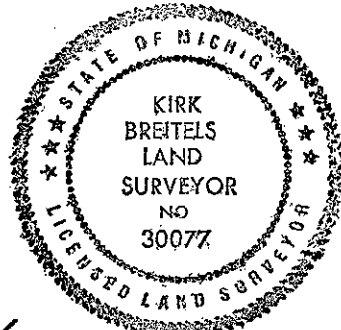

Signed by [Signature]
Surveyor's Michigan License No. 30077

Date 2/6/96