

FEB 14 1997

COMMISSION KENT COUNTY REMONUMENTATION

LAND CORNER RECORDATION CERTIFICATE  
Filing Requirement of Act 74, Mich. P.A. 1970

For corners in

KENT COUNTY (County)	Located In: #	Corner Code #
1. Public Land Survey	T <u>8N</u> R <u>11W</u>	<u>H-8</u>
	T _____ R _____	_____
	T _____ R _____	_____
	T _____ R _____	_____
2. Property Controlling in Section	S _____ T _____ R _____	_____
	S _____ T _____ R _____	_____
3. Miscellaneous Property in Sec.	S _____ T _____ R _____	_____
	S _____ T _____ R _____	_____

STATE OF MICHIGAN  
COUNTY OF KENT  
RECEIVED FOR RECORD  
56 MAR 20 AM 8:57  
REG. OF DEEDS  
*Lucy Bond*  
**9079**  
Register of Deeds Stamp & File Number

4. Lot No. \_\_\_\_\_, Recorded Plat \_\_\_\_\_  
5. Private Claims \_\_\_\_\_

I, Kirk Breitels, in a field survey on Jan. 29, 1996 do hereby state that under requirements of P.A. 74, Michigan P.A. of 1970, the corner points mentioned in lines 1 and 2 above were in conformance with regulations and rules therefore as required in the current manual of survey instructions of the United States Department of the Interior, Bureau of Land Management or by a decree of a Court of Law and /or that the corner points mentioned in lines 3, 4 and 5 above were in conformance with the rules of the Michigan Board of Land Surveyors or by a Decree of a Court of Law; established, re-established, monumented, recovered, found as expressed below:

A	B	C	D	E	F	G	H	I	J	K	L	M
1												
2	6	5	4	3	2	1						
3												
4	7	8	9	10	11	12						
5												
6	18	17	16	15	14	13						
7												
8	19	20	21	22	23	24						
9												
10	30	29	28	27	26	25						
11												
12	31	32	33	34	35	36						
13												

NOTE: Not more than 2 corners, all in the same town and range, may be recorded on this certificate.  
P.A. 345 1990 KENT COUNTY  
PEER APPROVED 3/1/96  
CHAIRMAN *Harry Stuber*

A. Description of original monument and accessories and/or subsequent restoration:

H-8	1837	GLO	Whitcomb	Not Set
	1973	Kent Co. Wit.		Mon. Box
	1983	LCRC #3232	Bonnema	1/2" Iron in Mon. Box
	1992	LCRC #6581	Marschall	Set Kent County Monument in Mon. Box

The position of this corner was previously approved by the Kent County Remonumentation Peer Group, monumented by Chris Marschall on 10/8/92 and was recorded per LCRC #6581.

B. Description of corner evidence found and/or method applied in restoring or reestablishing corner:

H-8 Found standard Kent Co. Mon. (Harrison) per witnesses from above LCRC as set by Chris Marschall in place of the 1/2" Pipe he found inside a Mon. Box. Said Pipe checks with Kent Co. Wit. and LCRC #3232.

LCRC #6581


Nail & KC Remon. tag W. side U. Pole	N03°E	45.86'	NE cor. Pole Barn
Nail & KC Remon. tag SW side Quad 10" Ash	N43°W	87.60'	S11°W 136.35'
SE corner catch basin rim	N73°W	87.36'	
NE corner catch basin rim	S76°W	94.97'	NW cor. garage
Nail & KC Remon. tag NW side U. Pole	S67°W	111.90'	S12°E 141.13'

The selected location is accepted by me and is generally accepted by professional surveyors as the best available evidence of the position of the corner.

C. Description of monument for corner and accessories established to perpetuate locating the position of the corner:

H-8 Standard Kent County Monument in Mon. Box

Nail & KC Remon. tag W. side U. Pole	N03°E	45.86'
Nail & KC Remon. tag SW side Quad 12" Ash	N43°W	87.63'
SE corner catch basin rim	N73°W	87.36'
NE corner catch basin rim	S76°W	94.97'
NE cor. Pole Barn	S11°W	136.35'
NW cor. Garage (Hse. #6304)	S12°E	141.13'

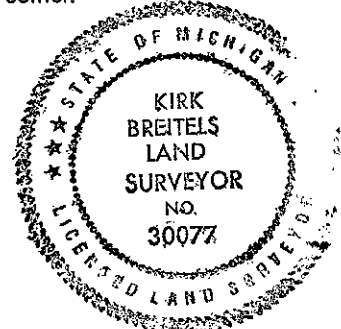

Signed by *Kirk Breitels*  
Surveyor's Michigan License No. 30077

Date 2/6/96