

FEB 14 1997

KENT COUNTY REMONUMENTATION

COMMISSION LAND CORNER RECORDATION CERTIFICATE

Filing Requirement of Act 74, Mich. P.A. 1970

For corners in KENT COUNTY
(County)

Located In:

Corner Code #

1. Public Land Survey	#	T	8N	R	11W	H-11
		T		R		
		T		R		
		T		R		
2. Property Controlling In Section	S	T		R		
	S	T		R		
3. Miscellaneous Property in Section	S	T		R		
	S	T		R		

REG. OF DEEDS

Lucy Bond

96 MAR 20 AM 8:57

STATE OF MICHIGAN
COUNTY OF KENT
RECEIVED FOR RECORD

9081

Register of Deeds Stamp & File Number

4. Lot No. _____, Recorded Plat _____
5. Private Claims _____

A	B	C	D	E	F	G	H	I	J	K	L	M
2	6	5	4	3	2	1						
3												
4	7	8	9	10	11	12						
5												
6	18	17	16	15	14	13						
7												
8	19	20	21	22	23	24						
9												
10	30	29	28	27	26	25						
11												
12	31	32	33	34	35	36						
13												

I, Kirk Breitels, in a field survey on Jan. 15, 1996,

do hereby certify that under requirements of P.A. 74, Michigan P.A. of 1970, the corner points mentioned in lines 1 and 2 above were in conformance with regulations and rules therefore as required in the current manual of survey instructions of the United States Department of the Interior, Bureau of Land Management or by a decree of a Court of Law and/or that the corner points mentioned in lines 3, 4 and 5 above were in conformance with the rules of the Michigan Board of Professional Surveyors or by a Decree of a Court of Law; established, re-established, monumented, re-monumented, recovered, found as expressed below:

NOTE: Not more than 4 corners, all in the same town and range, may be recorded on this certificate.

A. Description of original monument and accessories and/or subsequent restoration:

H-11	1831	GLO	Mullet	Set Post
	1970	Kent Co. Wit.		Mon. Box
	1973	LCRC #506	Spicer	Iron in Mon. Box
	1972	LCRC #559	VanKooten	Iron in Mon. Box
	1981	LCRC #2340	Bueche	Set Kent County Monument
	1988	LCRC #4848	Bueche	Reset Kent County Monument

P.A. 345 1990 KENT COUNTY
PEER APPROVED 3/7/96
CHAIRMAN Harry Huber

The position of this corner was previously approved by the Kent County Remonumentation Peer Group, monumented by John C. Bueche on 11/2/81 and was recorded per LCRC #2340.

B. Description of corner evidence found and/or method applied in restoring or reestablishing corner:

H-11 Found standard Kent Co. Mon. (Harrison) per witnesses from above LCRC as set by John C. Bueche in 1988 at the same location he set in 1981 in place of the 1/2" x 18" Iron he found inside a Mon. Box. Said Iron in Mon. Box checks with Kent Co. Wit. and LCRC's #506 & #559.

LCRC #2340 & #4848


Nail & KC Remon. tag W. side 38" Oak	N00°E	53.61'
Nail & KC Remon. tag SW side 12" Pine	N30°W	44.87'
Nail & KC Remon. tag SW side 10" Pine	S55°E	55.29'
SW corner conc. foundation to garage on C/L bit E-W	N28°E	77.71'

The selected location is accepted by me and is generally accepted by professional surveyors as the best available evidence of the position of the original corner.

C. Description of monument for corner and accessories established to perpetuate locating the position of the corner:

H-11 Standard Kent County Monument

New Nail & KC Remon. tag W. side 42" Oak	N00°E	53.61'
New Nail & KC Remon. tag SW side 14" Pine	N30°W	44.85'
New Nail & KC Remon. tag SW side 12" Pine	S55°E	55.25'
SW corner conc. foundation to garage	N28°E	77.69'
Set Nail & KC Remon. tag E. side 12" Pine	S00°E	43.92'
Fd. Nail & KC Remon. tag W. side P. Pole on C/L bit E-W	N00°E	32.25'

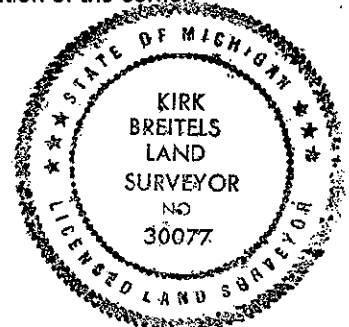

Signed by *Kirk Breitels*
Surveyor's Michigan License No. 30077

Date 2/6/96