

SURVEY & REMONUMENTATION

KENT COUNTY REMONUMENTATION

FEB 14 1997

LAND CORNER RECORDATION CERTIFICATE
Filing Requirement of Act 74, Mich. P.A. 1970

For corners in
KENT COUNTY
(County)

Located In:	Corner Code #
T8N R11W	H-12
T___ R___	_____
T___ R___	_____
T___ R___	_____
S___ T___ R___	_____
S___ T___ R___	_____
S___ T___ R___	_____
S___ T___ R___	_____

REG. OF DEEDS

Handwritten signature

96 OCT 18 AM 8:19

STATE OF MICHIGAN
COUNTY OF KENT
RECEIVED FOR RECORD

9397

Register of Deeds Stamp & File Number

4. Lot No. _____, Recorded Plat _____
5. Private Claims _____

I, Kirk Breitels, in a field survey on Sept. 9, 1996 do hereby state that under requirements of P.A. 74, Michigan P.A. of 1970, the corner points mentioned in lines 1 and 2 above were in conformance with regulations and rules therefore as required in the current manual of survey instructions of the United States Department of the Interior, Bureau of Land Management or by a decree of a Court of Law and for that the corner points mentioned in lines 3, 4 and 5 above were in conformance with the rules of the Michigan Board of Land Surveyors or by a Decree of a Court of Law; established, re-established, monumented, recovered, found as expressed below.

NOTE: Not more than 2 corners, all in the same town and range, may be recorded on this certificate.

	A	B	C	D	E	F	G	H	I	J	K	L	M
1													
2	6		5		4		3		2		1		
3													
4	7		8		9		10		11		12		
5													
6	18		17		16		15		14		13		
7													
8	19		20		21		22		23		24		
9													
10	30		29		28		27		26		25		
11													
12	31		32		33		34		35		36		
13													

A. Description of original monument and accessories and/or subsequent restoration:

H-12 1837---GLO---Not Set Kent Co. Wit.---Wit. given (all gone)
1948-72--Williams & Works---Set/Used Iron at intersection of 1/4 lines
28" Oak NE 41.85' 8" Oak ENE 38.85' 12" Oak SE 45.0'
12" Oak S 10.6' 18" Cherry NW 31.9'
1977---LCRC #1030---Bonnema---"T" Iron
SE cor. wing wall on bldg. W 70.90' NE cor. wing wall on bldg. NW 94.70'
Nail in 32" Oak NE 42.91' Nail in 12" Oak ENE 39.22'
Nail in 16" Oak SE 45.38'

B. Description of corner evidence found and/or method applied in restoring or reestablishing corner:


H-12 Found "T" Iron over another "T" Iron near E'ly edge of asph. parking lot per the following witnesses:
SE cor. wing wall W 70.90' Nail in 36" Oak NE 42.91'
NE cor. wing wall NW 94.70' C/L 18" Stump SE 45.4'

Said "T" Irons are 0.5' E. and less than 0.1' S. from intersection of 1/4 lines and agrees with survey measurements of others.

The "T" Irons are accepted by me and is generally accepted by professional surveyors as the best available evidence of the position of the corner.

C. Description of monument for corner and accessories established to perpetuate locating the position of the corner:

H-12 Set Standard Kent County Monument in place of the two "T" Irons.
Set Nail & KC Remon. tag W. side P. Pole N20°W 94.59'
Set Nail & KC Remon. tag SE side 36" Oak N45°E 42.91'
Set Nail & KC Remon. tag E. side 14" Oak S30°E 26.98'
NE corner conc. blk. wing wall N60°W 94.73'
SE corner conc. blk. wing wall N75°W 70.95'
Easterly edge asph. parking lot is E. 1.5'±

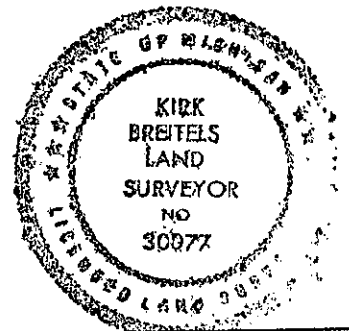

Signed by *Kirk Breitels*
Surveyor's Michigan License No. 30077

Date 10/11/96

P.A. 345 1990 KENT COUNTY
PEER APPROVED B/22/96
CHAIRMAN *Frank Hubert*