

FEB 14 1997

KENT COUNTY REMONUMENTATION

COMMISSION

LAND CORNER RECORDATION CERTIFICATE

Filing Requirement of Act 74, Mich. P.A. 1970

For corners in KENT COUNTY (County)

Located In:

Corner Code #

Table with 3 columns: Description, T/R, and Corner Code #. Includes rows for Public Land Survey, Property Controlling in Section, and Miscellaneous Property in Section.

REQ. OF DEEDS

Handwritten signature


96 MAR 20 AM 8:58

STATE OF MICHIGAN COUNTY OF KENT RECEIVED FOR RECORD

9085

Register of Deeds Stamp & File Number

4. Lot No. , Recorded Plat
5. Private Claims

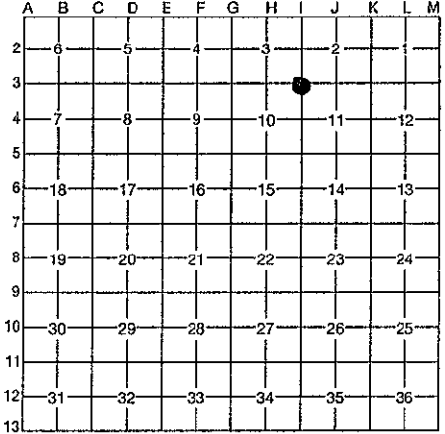

I, Kirk Breitels, in a field survey on Jan. 16, 1996

do hereby certify that under requirements of P.A. 74, Michigan P.A. of 1970, the corner points mentioned in lines 1 and 2 above were in conformance with regulations and rules therefore as required in the current manual of survey instructions of the United States Department of the Interior, Bureau of Land Management or by a decree of a Court of Law and/or that the corner points mentioned in lines 3, 4 and 5 above were in conformance with the rules of the Michigan Board of Professional Surveyors or by a Decree of a Court of Law; established, re-established, monumented, re-monumented, recovered, found as expressed below:

NOTE: Not more than 4 corners, all in the same town and range, may be recorded on this certificate.

A. Description of original monument and accessories and/or subsequent restoration:

Table listing monument details for I-3, including dates (1837, 1956, 1983, 1983, 1988), descriptions (GLO, Kent Co. Wit., LCRC #3207, LCRC #3492, LCRC #4850), names (Whitcomb, Meyer, Stadt, Bueche), and monument types (Set Post, Leaded Stone, Set Kent County Monument, Kent County Monument). Includes P.A. 345 1990 KENT COUNTY and CHAIRMAN signature.

The position of this corner was previously approved by the Kent County Remonumentation Peer Group, monumented by Russel E. Stadt on 8/2/83 and was recorded per LCRC #3492.

B. Description of corner evidence found and/or method applied in restoring or reestablishing corner:

I-3 Found standard Kent Co. Mon. (Harrison) per witnesses from above LCRC as set by Russel E. Stadt in place of the Leaded Stone he found. Said Leaded Stone checks with Kent Co. Wit. and LCRC 3207.

Table comparing measurements for LCRC #3492 and LCRC #4850. Columns include measurement type (Nail/tag), direction (N20°W, East, N10°E, S30°W, S55°W, S60°E), and distance (36.37', 12.85', 28.70', 35.75', 0.75', 34.37').

The selected location is accepted by me and is generally accepted by professional surveyors as the best available evidence of the position of the original corner.

C. Description of monument for corner and accessories established to perpetuate locating the position of the corner:

Table listing monument details for I-3 Standard Kent County Monument, including monument type (Nail & KC Remon. tag), direction (N20°W, N90°E, N10°E, S60°E, S30°W), and distance (36.39', 12.70', 28.82', 34.23', 18.70').



Signed by [Signature] Surveyor's Michigan License No. 30077

Date 2/6/96