

FEB 14 1997

KENT COUNTY REMONUMENTATION

COMMISSION

LAND CORNER RECORDATION CERTIFICATE

Filing Requirement of Act 74, Mich. P.A. 1970

For corners in KENT COUNTY (County)

Located In:

Corner Code #

- 1. Public Land Survey T 8N R 11W I-5
2. Property Controlling in Section S T R
3. Miscellaneous Property in Section S T R

REG. OF DEEDS


96 MAR 20 AM 8:58

STATE OF MICHIGAN COUNTY OF KENT RECEIVED FOR RECORD

9087

Register of Deeds Stamp & File Number

- 4. Lot No. , Recorded Plat
5. Private Claims

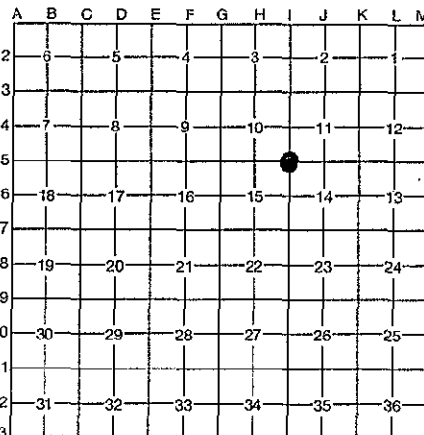

I, Kirk Breitels, in a field survey on Jan. 16, 1996, do hereby certify that under requirements of P.A. 74, Michigan P.A. of 1970, the corner points mentioned in lines 1 and 2 above were in conformance with regulations and rules therefore as required in the current manual of survey instructions of the United States Department of the Interior, Bureau of Land Management or by a decree of a Court of Law and/or that the corner points mentioned in lines 3, 4 and 5 above were in conformance with the rules of the Michigan Board of Professional Surveyors or by a Decree of a Court of Law; established, re-established, monumented, re-monumented, recovered, found as expressed below:

NOTE: Not more than 4 corners, all in the same town and range, may be recorded on this certificate.

A. Description of original monument and accessories and/or subsequent restoration:

Table with 5 columns: Corner Code, Year, Description, Name, and Monument Type. Includes entries for 1837, 1930, 1975, 1981, and 1988.

P.A. 345 1990 KENT COUNTY

PEER APPROVED 3/7/96

CHAIRMAN Harry Hufner

The position of this corner was previously approved by the Kent County Remonumentation Peer Group, monumented by John C. Bueche on 11/6/81 and was recorded per LCRC #2321.

B. Description of corner evidence found and/or method applied in restoring or reestablishing corner:

I-5 Found standard Kent Co. Mon. (Harrison) per witnesses from above LCRC as set by John C. Bueche in place of the Stone and 1/2" x 12" Iron he found. Said Stone checks with Kent Co. Wit. and LCRC #826. (Iron was 0.25' N. & 0.4' E. of Stone).

Table comparing LCRC #2321 and LCRC #4852 with bearings and distances for various monument types like Nail/tag 14" Ash, Hickory, etc.

The selected location is accepted by me and is generally accepted by professional surveyors as the best available evidence of the position of the original corner.

C. Description of monument for corner and accessories established to perpetuate locating the position of the corner:

Table for I-5 Standard Kent County Monument listing bearings and distances for new and set nails, and old fence locations.



Signed by [Signature]

Date 2/6/96

Surveyor's Michigan License No. 30077