

FEB 14 1997

KENT COUNTY REMONUMENTATION

COMMUNITY LAND CORNER RECORDATION CERTIFICATE
Filing Requirement of Act 74, Mich. P.A. 1970

For corners in
KENT COUNTY
(County)

Located In:

Corner Code #

1. Public Land Survey	T	8N	R	11W	I-10
	T		R		
	T		R		
	T		R		
2. Property Controlling in Section	S	T	R		
	S	T	R		
3. Miscellaneous Property in Section	S	T	R		
	S	T	R		

REG. OF DEEDS

96 MAR 20 AM 8:58


STATE OF MICHIGAN
COUNTY OF KENT
RECEIVED FOR RECORD

9092

Register of Deeds Stamp & File Number

4. Lot No. _____, Recorded Plat _____
5. Private Claims _____

I, Kirk Breitels, in a field survey on Jan. 15, 1996, do hereby certify that under requirements of P.A. 74, Michigan P.A. of 1970, the corner points mentioned in lines 1 and 2 above were in conformance with regulations and rules therefore as required in the current manual of survey instructions of the United States Department of the Interior, Bureau of Land Management or by a decree of a Court of Law and/or that the corner points mentioned in lines 3, 4 and 5 above were in conformance with the rules of the Michigan Board of Professional Surveyors or by a Decree of a Court of Law; established, re-established, monumented, re-monumented, recovered, found as expressed below:

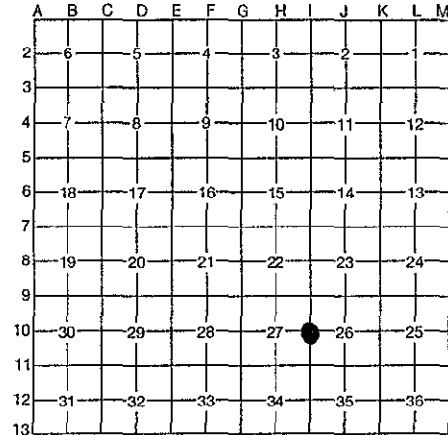

NOTE: Not more than 4 corners, all in the same town and range, may be recorded on this certificate.

A. Description of original monument and accessories and/or subsequent restoration:

I-10	1831	GLO	Mullet	Set Post
		Kent Co. Wit.		"Plat Monument"
	1983	LCRC #3208	Merdzinski	Concrete Monument
	1983	LCRC #3312	E. Glaza	Concrete Monument
	1983	LCRC #3531	Stadt	Set Kent County Monument
	1988	LCRC #4857	Bueche	Kent County Monument

P.A. 345 1990 KENT COUNTY
PEER APPROVED 3/7/96
CHAIRMAN *[Signature]*

The position of this corner was previously approved by the Kent County Remonumentation Peer Group, monumented by Russel E. Stadt on 9/30/83 and was recorded per LCRC #3531.

B. Description of corner evidence found and/or method applied in restoring or reestablishing corner:

I-10 Found standard Kent Co. Mon. (Harrison) per witnesses from above LCRC as set by Russel E. Stadt in place of the Concrete Monument he found. Said Concrete Monument checks with Kent Co. Wit. and LCRC's #3208 & #3312.

<u>LCRC #3531</u>		<u>LCRC #4857</u>	
Nail/tag 26" Oak	S30°W 28.48'	Nail/tag 30" Oak	S30°W 28.48'
Nail/tag 8" Oak	N75°W 11.00'	Nail/tag 28" Oak	N30°W 24.20'
Nail/tag 8" Oak	East 19.61'	Nail/tag 26" Oak	S14°W 58.85'
Nail/tag 26" Oak	N30°W 24.20'	Top C/L steel fc. cor.	S85°W 39.40'
Nail/tag 8" Oak	N85°W 31.08'	Nail/tag 14" Oak	N80°E 47.27'
Nail/tag 24" Oak	S14°W 58.85'		

The selected location is accepted by me and is generally accepted by professional surveyors as the best available evidence of the position of the original corner.

C. Description of monument for corner and accessories established to perpetuate locating the position of the corner:

I-10 Standard Kent County Monument

New Nail & KC Remon. tag W. side 30" Oak	S30°W	28.44'
New Nail & KC Remon. tag NE side 30" Oak	N30°W	24.24'
New Nail & KC Remon. tag W. side 28" Oak	S14°W	58.79'
Set Nail & KC Remon. tag S. side 18" Oak	N80°E	47.23'
Fd. Nail & KC Remon. tag N. side 8" Sassafras	N70°E	24.03'

Fence corner for fence S. & W. is 0.4' S. & 0.1' W.



Signed by *[Signature]*
Surveyor's Michigan License No. 30077

Date 2/6/96