

SURVEY & REMONUMENTATION

FEB 14 1997

COMMISSION

KENT COUNTY REMONUMENTATION

LAND CORNER RECORDATION CERTIFICATE
Filing Requirement of Act 74, Mich. P.A. 1970

For corners in

KENT COUNTY

(County)

Located In:

Corner Code #

- | | | |
|------------------------------------|--------------------------|------------|
| 1. Public Land Survey | T <u>8N</u> R <u>11W</u> | <u>J-4</u> |
| | T _____ R _____ | _____ |
| | T _____ R _____ | _____ |
| | T _____ R _____ | _____ |
| 2. Property Controlling in Section | S _____ T _____ R _____ | _____ |
| | S _____ T _____ R _____ | _____ |
| 3. Miscellaneous Property in Sec. | S _____ T _____ R _____ | _____ |
| | S _____ T _____ R _____ | _____ |

4. Lot No. _____, Recorded Plat _____
5. Private Claims _____

I, Kirk Breitels, in a field survey on Sept. 13, 1996 do hereby state that under requirements of P.A. 74, Michigan P.A. of 1970, the corner points mentioned in lines 1 and 2 above were in conformance with regulations and rules therefore as required in the current manual of survey instructions of the United States Department of the Interior, Bureau of Land Management or by a decree of a Court of Law and/or that the corner points mentioned in lines 3, 4 and 5 above were in conformance with the rules of the Michigan Board of Land Surveyors or by a Decree of a Court of Law; established, re-established, monumented, recovered, found as expressed below:

NOTE: Not more than 2 corners, all in the same town and range, may be recorded on this certificate.

STATE OF MICHIGAN
COUNTY OF KENT
RECEIVED FOR RECORD
96 OCT 18 AM 9:20
REG. OF DEEDS
Lucy Bond
9405
Register of Deeds Stamp & File Number

A	B	C	D	E	F	G	H	I	J	K	L	M
1												
2	6	5	4	3	2	1						
3												
4	7	8	9	10	11	12						
5												
6	18	17	16	15	14	13						
7												
8	19	20	21	22	23	24						
9												
10	30	29	28	27	26	25						
11												
12	31	32	33	34	35	36						
13												

A. Description of original monument and accessories and/or subsequent restoration:

- J-4 1837---GLO---Not Set
1955-64---Williams & Works---Set Iron/Used (no method explained)
1964---Kent Co. Wit.---Mon. Box
1965-72---Williams & Works---Set Iron/Used at intersection of 1/4 lines
Found Mon. Box 6.3' East of true center
1972---LCRC #196---Spicer---"T" Iron
18" Oak N30°W 55.65' 16" Poplar S20°W 59.08' Mon. Box E 6.30'
1983---LCRC #3257---C. Hay---"T" Iron: MBT Riser SE 59.45' Capped Iron SW 36.80'
18" Oak N30°W 55.54' 16" Poplar S20°W 58.89' Mon. Box E. 6.30'

B. Description of corner evidence found and/or method applied in restoring or reestablishing corner:


- J-4 Found "T" Iron per the following witnesses:
Iron Pipe in Mon. Box E 6.3' NW cor. MBT Box SE 59.4'
24" Oak N30°W 55.5' 36" Poplar S20°W 59.2'

Said "T" Iron is 0.1' E. and 0.2' S. from intersection of 1/4 lines and agrees with survey measurements of others. "Evergreen Meadows No. 1" indicates Center of Section per LCRC #3257.

The "T" Iron is accepted by me and is generally accepted by professional surveyors as the best available evidence of the position of the corner.

C. Description of monument for corner and accessories established to perpetuate locating the position of the corner:

- J-4 Set Standard Kent County Monument in place of the "T" Iron
Iron Pipe in Mon. Box East 6.28'
Set Nail & KC Remon. tag NE side 24" Oak N30°W 55.44'
Set Nail & KC Remon. tag E. side 36" Poplar S20°W 59.20'
NW cor. Tel. box (2' above grnd.) S60°E 59.40'
SW cor. brick pillar (S. pillar) N60°W 35.25'

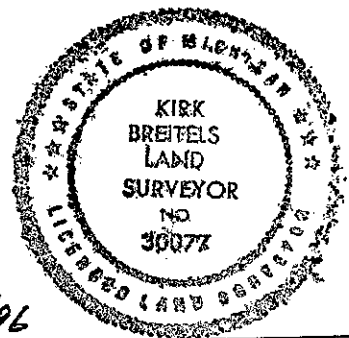

Signed by *Kirk Breitels*
Surveyor's Michigan License No. 30077

Date 10/11/96

P.A. 345 1990 KENT COUNTY
PEER APPROVED 8/22/96
CHAIRMAN *Harry Hubert*