

KENT COUNTY REMONUMENTATION

LAND CORNER RECORDATION CERTIFICATE

Filing Requirement of Act 74, Mich. P.A. 1970

For corners in  
KENT COUNTY  
(County)

Located In:

Corner Code #

1. Public Land Survey	T	8N	R	11W	J-5
	T		R		
	T		R		
	T		R		
2. Property Controlling in Section	S		T	R	
	S		T	R	
3. Miscellaneous Property in Section	S		T	R	
	S		T	R	

STATE OF MICHIGAN  
COUNTY OF KENT  
RECEIVED FOR RECORD


96 MAR 20 AM 8:58

REG. OF DEEDS

9096

Register of Deeds Stamp & File Number

4. Lot No. \_\_\_\_\_, Recorded Plat \_\_\_\_\_  
5. Private Claims \_\_\_\_\_

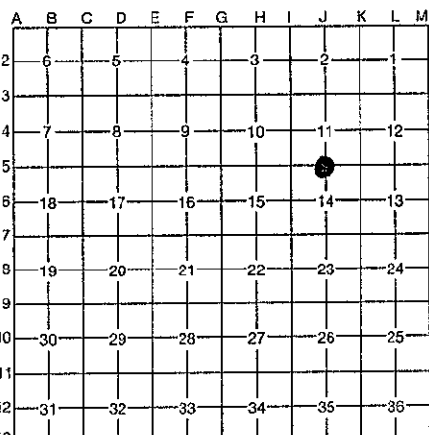

I, Kirk Breitels, in a field survey on Jan. 16, 1996, do hereby certify that under requirements of P.A. 74, Michigan P.A. of 1970, the corner points mentioned in lines 1 and 2 above were in conformance with regulations and rules therefore as required in the current manual of survey instructions of the United States Department of the Interior, Bureau of Land Management or by a decree of a Court of Law and/or that the corner points mentioned in lines 3, 4 and 5 above were in conformance with the rules of the Michigan Board of Professional Surveyors or by a Decree of a Court of Law; established, re-established, monumented, re-monumented, recovered, found as expressed below:

**NOTE: Not more than 4 corners, all in the same town and range, may be recorded on this certificate.**

A. Description of original monument and accessories and/or subsequent restoration:

J-5	1837	GLO	Whitcomb	Set Post
		Kent Co. Wit.		No. desc.-witnesses given
	1973	LCRC #557	VanKooten	"T" Iron
	1981	LCRC #2278	Bueche	Set Kent County Monument
	1988	LCRC #4861	Bueche	Kent County Monument

P.A. 345 1990 KENT COUNTY  
PEER APPROVED 3/7/96  
CHAMAN *[Signature]*

The position of this corner was previously approved by the Kent County Remonumentation Peer Group, monumented by John C. Bueche on 10/3/81 and was recorded per LCRC #2278.

B. Description of corner evidence found and/or method applied in restoring or reestablishing corner:


J-5 Found standard Kent Co. Mon. (Harrison) per witnesses from above LCRC as set by John C. Bueche in place of the "T" Iron he found. Said "T" Iron checks with Kent Co. Wit. and LCRC #557.

<u>LCRC #2278</u>		<u>LCRC #4861</u>	
SE cor. fndn.	N75°W 68.82'	SE cor. fndn.	N75°W 68.82'
Nail/tag 30" Oak	S07°E 21.07'	Nail/tag 32" Oak	S07°E 21.06'
Nail/tag 24" Oak	N10°W 99.32'	Nail/tag 26" Oak	N10°W 99.32'
Nail/tag 36" Oak	S55°E 63.78'	Nail/tag 38" Oak	S55°E 63.78'
Cor. is on W. edge of bit. N-S		Nail/tag Fc. Post	N34°E 56.80'
C/L bit. rd. (June View)	S. 50'±		

The selected location is accepted by me and is generally accepted by professional surveyors as the best available evidence of the position of the original corner.

C. Description of monument for corner and accessories established to perpetuate locating the position of the corner:

J-5 Standard Kent County Monument	
SE corner garage foundation	N75°W 68.77'
New Nail & KC Remon. tag W. side 36" Oak	S07°E 21.10'
New Nail & KC Remon. tag E. side 28" Oak	N10°W 99.26'
New Nail & KC Remon. tag W. side 40" Oak	S55°E 63.81'
Nail & KC Remon. tag NW side Fence Post	N34°E 56.80'
Cor. is on W. edge bit N-S, C/L bit. rd. (June View)	is S. 50'±

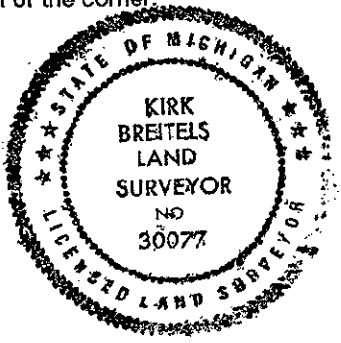

Signed by *[Signature]*  
Surveyor's Michigan License No. 30077

Date 2/6/96