

SURVEY & REMONUMENTATION

KENT COUNTY REMONUMENTATION

FEB 14 1997

LAND CORNER RECORDATION CERTIFICATE
COMMISSION Filing Requirement of Act 74, Mich. P.A. 1970

For corners in
KENT COUNTY
 (County)

Located In:

Corner Code #

1. Public Land Survey	T	8N	R	11W	J-9
	T		R		
	T		R		
	T		R		
2. Property Controlling in Section	S		T	R	
	S		T	R	
3. Miscellaneous Property in Section	S		T	R	
	S		T	R	

4. Lot No. _____, Recorded Plat _____
 5. Private Claims _____

STATE OF MICHIGAN
 COUNTY OF KENT
 RECEIVED FOR RECORD

96 MAR 20 AM 8:58

REG. OF DEEDS


Lucy Bond

9098

Register of Deeds Stamp & File Number

I, **Kirk Breitels**, in a field survey on **Jan. 15**, 19 **96**, do hereby certify that under requirements of P.A. 74, Michigan P.A. of 1970, the corner points mentioned in lines 1 and 2 above were in conformance with regulations and rules therefore as required in the current manual of survey instructions of the United States Department of the Interior, Bureau of Land Management or by a decree of a Court of Law and/or that the corner points mentioned in lines 3, 4 and 5 above were in conformance with the rules of the Michigan Board of Professional Surveyors or by a Decree of a Court of Law; established, re-established, monumented, re-monumented, recovered, found as expressed below:

NOTE: Not more than 4 corners, all in the same town and range, may be recorded on this certificate.

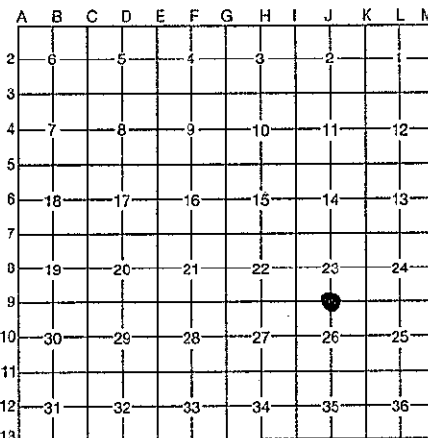

A. Description of original monument and accessories and/or subsequent restoration:

J-9	1831	GLO	Mullet	Set Post
	1944	Kent Co. Wit.		"+" cut in conc.
	1972	LCRC #117	Chambers	1" Iron in Mon. Box
	1981	LCRC #2383	Bueche	Set Kent County Monument
	1988	LCRC #4863	Bueche	Kent County Monument

P.A. 345 1990 KENT COUNTY

PEER APPROVED *3/2/96*
 CHAIRMAN *Harry Kuper*

The position of this corner was previously approved by the Kent County Remonumentation Peer Group, monumented by John C. Bueche on 11/16/81 and was recorded per LCRC #2383.

B. Description of corner evidence found and/or method applied in restoring or reestablishing corner:

J-9 Found standard Kent Co. Mon. (Harrison) per witnesses from above LCRC as set by John C. Bueche in place of the 1" x 24" Iron Rod he found. Said Iron Rod checks with LCRC #117 measurements of others. Kent Co. Wit. all gone.

LCRC #2383 & #4863

Nail & MSHD tag S. side P. Pole	S85°E	61.88'
Nail & MSHD tag N. side P. Pole	N85°W	58.48'
NE corner of brick bldg.	N65°W	150.32'
"X" cut in conc. culvert	S40°W	72.84'
Mon. is C/L of left turn land (5 lanes wide)		

The selected location is accepted by me and is generally accepted by professional surveyors as the best available evidence of the position of the original corner.

C. Description of monument for corner and accessories established to perpetuate locating the position of the corner:

J-9 Standard Kent County Monument

Nail & MSHD tag N. side P. Pole	N85°W	58.46'
NE corner of brick bldg.	N65°W	150.24'
Set Nail & KC Remon. tag S. side P. Pole	S85°E	61.88'
Top C/L fire hydrant	N35°W	87.24'
C/L SW bolt of light pole base	N35°E	107.70'
Mon. is C/L of left turn land (5 lanes wide)		

All meas.
by EDM



Signed by *Kirk Breitels*

Date *2/6/96*

Surveyor's Michigan License No. 30077