2/2

SURVEY & REMONUMENTATION

FEB 1 4 1997

COMMISSION

KENT COUNTY REMONUMENTATION

LAND CORNER RECORDATION CERTIFICATE

Filing Requirement of Act 74, Mich. P.A. 1970

STATE OF MICHIGAN COUNTY OF KENT RECEIVED FOR RECORD 96 OCT 18 AM 8:20

REG. OF DEEDS

For corners in KENT COUNTY (County) Located In: Corner Code #

1. Public Land Survey T8N R 11W J-10
   T___ R___
   T___ R___
   T___ R___
2. Property Controlling in Section S___ T___ R___
   S___ T___ R___
   S___ T___ R___
3. Miscellaneous Property in Sec. S___ T___ R___

9402

Register of Deeds Stamp & File Number

4. Lot No. _____, Recorded Plat _____
5. Private Claims _____

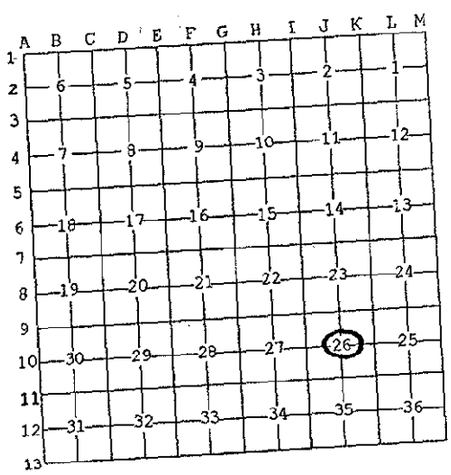

I, Kirk Breitels, in a field survey on Sept. 9, 19 96 do hereby state that under requirements of P.A. 74, Michigan P.A. of 1970, the corner points mentioned in lines 1 and 2 above were in conformance with regulations and rules therefore as required in the current manual of survey instructions of the United States Department of the Interior, Bureau of Land Management or by a decree of a Court of Law and /or that the corner points mentioned in lines 3, 4 and 5 above were in conformance with the rules of the Michigan Board of Land Surveyors or by a Decree of a Court of Law; established, re-established, monumented, recovered, found as expressed below:

NOTE: Not more than 2 corners, all in the same town and range, may be recorded on this certificate.

A. Description of original monument and accessories and/or subsequent restoration:

J-10 1837---GLO---Not Set
1924-88--Williams & Works---Set/Used Iron 22.5' E. of plat monument (1988-checked good with LCRC #284)
1972---LCRC #284---VanKooten---1 1/2" Iron
36" Oak W 14.78' PP NNW 111.19' TP SSW 60.10'
1986---Survey---E. Glaza---C 1/4 cor. per LCRC #284
1987---LCRC #4506---Wickham---1" Iron Pipe per VanKooten wit.
TP S25°W 60.10' PP N20°W 111.26' 36" Oak W 14.93'

B. Description of corner evidence found and/or method applied in restoring or reestablishing corner:

J-10 Found 1 1/2" Iron Pipe per the following witnesses:
PK W. side T. Pole S25°W 60.08' PK NE side P. Pole N20°W 111.22'
Nail N. side 40" Oak West 14.93'

Said 1 1/2" Iron Pipe is 3.9' S. and 0.1' W. from intersection of 1/4 lines and agrees with survey measurments of E. Glaza, All Points, Medema & VanKooten and Williams & Works.

The 1 1/2" Iron Pipe is accepted by me and is generally accepted by professional surveyors as the best available evidence of the position of the corner.

C. Description of monument for corner and accessories established to perpetuate locating the position of the corner:

J-10 Set Standard Kent County Monument in place of 1 1/2" Iron Pipe
Set Nail & KC Remon. tag N. side 50" Oak N75°W 84.95'
C/L top fire hydrant S40°W 40.52'
Set Nail & KC Remon. tag E. side P. Pole S20°W 91.93'
Set Nail & KC Remon. tag E. side P. Pole N10°W 111.24'
NW cor. 1' x 1' conc. pillar (@ ground) S60°E 39.98'
C/L N-S Asph. Rd. is E. 10'±

STATE OF MICHIGAN KIRK BREITELS LAND SURVEYOR MO 30077 LICENSED LAND SURVEYOR

Signed by Kirk Breitels Date 10/11/96

Surveyor's Michigan License No. 30077

P.A. 345 1990 KENT COUNTY
PEER APPROVED 8/22/96
CHAIRMAN Gary Huber

FORM APPROVED BY MICHIGAN STATE BOARD OF PROFESSIONAL SURVEYORS, JAN. 28, 19
REVISED MAY 14,19
REVISED JAN., 19
REVISED OCT., 19