

FEB 14 1997

KENT COUNTY REMONUMENTATION

COMMISSION LAND CORNER RECORDATION CERTIFICATE

Filing Requirement of Act 74, Mich. P.A. 1970

For corners in KENT COUNTY (County)

Located In:

Corner Code #

Table with 4 rows and 3 columns: Item, T, R, Corner Code #. Row 1: Public Land Survey, T 8N R 11W, J-13. Row 2: Property Controlling in Section, S T R. Row 3: Miscellaneous Property in Section, S T R.

REG. OF DEEDS

Handwritten signature

95 MAR 20 AM 8:58

STATE OF MICHIGAN COUNTY OF KENT RECEIVED FOR RECORD

9100

Register of Deeds Stamp & File Number

- 4. Lot No. , Recorded Plat
5. Private Claims

I, Kirk Breitels, in a field survey on Jan. 15, 1996, do hereby certify that under requirements of P.A. 74, Michigan P.A. of 1970, the corner points mentioned in lines 1 and 2 above were in conformance with regulations and rules therefore as required in the current manual of survey instructions of the United States Department of the Interior, Bureau of Land Management or by a decree of a Court of Law and/or that the corner points mentioned in lines 3, 4 and 5 above were in conformance with the rules of the Michigan Board of Professional Surveyors or by a Decree of a Court of Law; established, re-established, monumented, re-monumented, recovered, found as expressed below:

NOTE: Not more than 4 corners, all in the same town and range, may be recorded on this certificate.

A. Description of original monument and accessories and/or subsequent restoration:

Table with 4 columns: Corner Code, Year, Description, Monument Type. Includes entries for J-13 1831 GLO Mullet Set Post, 1974 LCRC #692 Bonnema Boat Spike, 1978 LCRC #1191 Merdzinski Boat Spike, 1981 LCRC #1789 Merdzinski Set Kent County Monument, 1988 LCRC #4865 Bueche Kent County Monument.

The position of this corner was previously approved by the Kent County Remonumentation Peer Group, monumented by John A. Merdzinski on 1/22/81 and was recorded per LCRC #1789.

B. Description of corner evidence found and/or method applied in restoring or reestablishing corner.

J-13 Found standard Kent Co. Mon. (Harrison) per witnesses from above LCRC as set by John A. Merdzinski in place of the 2 Boat Spikes and 3/4" Iron he found. Said Boat Spikes & 3/4" Iron check with Kent Co. Wit. and LCRC's #692 & #1191.

LCRC #1789 & #4865


Table with 4 columns: Evidence Description, Direction, Distance. Includes entries like Nail & KC Remon. tag S. side 24" Hickory N70°W 66.18', Nail & KC Remon. tag S. side 30" Maple N65°E 59.14', Nail & KC Remon. tag N. side 16" Pine S65°E 64.02', Nail & KC Remon. tag W. side 26" Hickory S15°E 70.45', Nail & KC Remon. tag W. side 24" Hickory S20°W 100.89', Nail & KC Remon. tag SE side 28" Hickory S45°W 29.80', KC Mon. (N 1/4, Sec. 2, T7N, R11W) East 33.06'

The selected location is accepted by me and is generally accepted by professional surveyors as the best available evidence of the position of the original corner.

C. Description of monument for corner and accessories established to perpetuate locating the position of the corner:

J-13 Standard Kent County Monument

Table with 4 columns: Monument Description, Direction, Distance. Includes entries like Nail & KC Remon. tag S. side 27" Hickory N70°W 66.18', Nail & KC Remon. tag S. side 33" Hickory N65°E 59.16', New Nail & KC Remon. tag E. side 30" Hickory S20°W 100.88', Nail & KC Remon. tag SE side 30" Hickory S45°W 29.82', Fd. Nail & KC Remon. tag W. side P. Pole S45°E 50.70', Kent Co. Mon. (J-1 T7N, R11W) East 33.06'

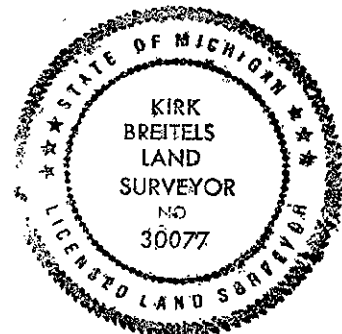

Signed by [Signature] Surveyor's Michigan License No. 30077

Date 2/6/96

