

FEB 14 1997

COMMISSION

LAND CORNER RECORDATION CERTIFICATE

Filing Requirement of Act 74, Mich. P.A. 1970

For corners in KENT COUNTY (County)

Located In:

Corner Code #

Table with 3 columns: Survey Type, Corner Code, and Section/Range/Block. Includes rows for Public Land Survey, Property Controlling in Section, and Miscellaneous Property in Section.

REG. OF DEEDS

Handwritten signature

96 MAR 20 AM 8:59

STATE OF MICHIGAN COUNTY OF KENT RECEIVED FOR RECORD

9106

Register of Deeds Stamp & File Number

4. Lot No. Recorded Plat
5. Private Claims

Grid table with columns A-L and rows 1-13. A dot is marked at row 7, column K.

I, Kirk Breitels, in a field survey on Jan. 16, 1996, do hereby certify that under requirements of P.A. 74, Michigan P.A. of 1970, the corner points mentioned in lines 1 and 2 above were in conformance with regulations and rules therefore as required in the current manual of survey instructions of the United States Department of the Interior, Bureau of Land Management or by a decree of a Court of Law and/or that the corner points mentioned in lines 3, 4 and 5 above were in conformance with the rules of the Michigan Board of Professional Surveyors or by a Decree of a Court of Law; established, re-established, monumented, re-monumented, recovered, found as expressed below:

NOTE: Not more than 4 corners, all in the same town and range, may be recorded on this certificate.

A. Description of original monument and accessories and/or subsequent restoration:

Table listing survey details: K-7 1837 GLO Whitcomb Set Post P.A. 345 1990 KENT COUNTY; 1972 LCRC #129 Chambers Solid Iron PEER APPROVED 3/7/96; 1972 LCRC #186 Spicer Solid Iron CHAIRMAN; 1981 LCRC #2380 Bueche Set Kent County Monument; 1988 LCRC #4870 Bueche Kent County Monument

The position of this corner was previously approved by the Kent County Remonumentation Peer Group, monumented by John C. Bueche on 11/18/81 and was recorded per LCRC #2380.

B. Description of corner evidence found and/or method applied in restoring or reestablishing corner:


K-7 Found standard Kent Co. Mon. (Harrison) per witnesses from above LCRC as set by John C. Bueche in place of the 1/2" x 4" Rerod inside a 3/4" x 12" Iron he found over a Painted Stone. Both Irons and Stone check with Kent Co. Wit. and LCRC's #129 & #186.

Table comparing LCRC #2380 and LCRC #4870 measurements: Nail & tag 8" Elm N20°E 30.44', Nail & tag 42" Oak N35°W 83.32', Nail & tag P. Pole N60°W 56.48', Nail & tag P. Pole S70°W 57.47', Bt. Spike West 74.47', Nail & tag P. Pole N60°W 56.48', Nail & tag P. Pole S70°W 58.04' new pole, Nail & tag fc. post S56°E 58.28', Bt. Spike West 74.47', C/L bit. N-S is W 77'±, C/L bit. E-W is S 2.5'±

The selected location is accepted by me and is generally accepted by professional surveyors as the best available evidence of the position of the original corner.

C. Description of monument for corner and accessories established to perpetuate locating the position of the corner:

Table listing monument details: K-7 Standard Kent County Monument; New Nail & KC Remon. tag SW side P. Pole N60°W 56.43'; Nail & KC Remon. tag S. side P. Pole S70°W 58.08'; Nail & KC Remon. tag W. side Wood Fence Post S56°E 58.30'; Set Nail & KC Remon. tag W. side Large Stump N15°E 279.54'; Set Nail & KC Remon. tag S. side P. Pole N80°E 208.06'; C/L N-S bit. is W. 77'±, C/L E-W bit. is S. 2.5'±

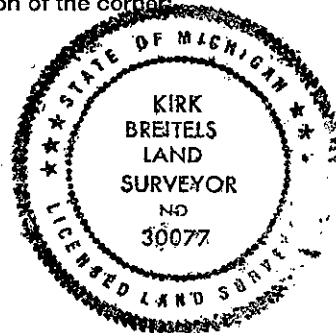

Signed by [Signature] 30077

Date 2/6/96

Surveyor's Michigan License No.