

FEB 14 1997

COMMISSION

KENT COUNTY REMONUMENTATION

LAND CORNER RECORDATION CERTIFICATE
Filing Requirement of Act 74, Mich. P.A. 1970

For corners in
KENT COUNTY

(County)

Located In: Corner Code #

1. Public Land Survey	T8N	R11W	L-2
	T	R	
	T	R	
	T	R	
2. Property Controlling in Section	S	T	R
	S	T	R
3. Miscellaneous Property in Sec.	S	T	R
	S	T	R

STATE OF MICHIGAN
COUNTY OF KENT
RECEIVED FOR RECORD
96 SEP 13 PM 12:04
REG. OF DEEDS
Luigi St. Paul

9351

Register of Deeds Stamp & File Number

4. Lot No. _____, Recorded Plat _____
5. Private Claims _____

I, Kirk Breitels, in a field survey on Aug. 26, 1996 do hereby state that under requirements of P.A. 74, Michigan P.A. of 1970, the corner points mentioned in lines 1 and 2 above were in conformance with regulations and rules therefore as required in the current manual of survey instructions of the United States Department of the Interior, Bureau of Land Management or by a decree of a Court of Law and for that the corner points mentioned in lines 3, 4 and 5 above were in conformance with the rules of the Michigan Board of Land Surveyors or by a Decree of a Court of Law; established, re-established, monumented, recovered, found as expressed below:

NOTE: Not more than 2 corners, all in the same town and range, may be recorded on this certificate.

A	B	C	D	E	F	G	H	I	J	K	L	M
1												1
2	6		5		4		3		2			
3												
4	7		8		9		10		11		12	
5												
6	18		17		16		15		14		13	
7												
8	19		20		21		22		23		24	
9												
10	30		29		28		27		26		25	
11												
12	31		32		33		34		35		36	
13												

A. Description of original monument and accessories and/or subsequent restoration:

- L-2 1837---GLO---Not Set
- 1938---Kent Co. Wit.---3/4" Iron: Fc. West 42' Fc. South 7'
15" Pine W 8.3' 18" Pine NE 14.6' 20" Oak SE 22.0'
- 1941-74---Williams & Works---Found and accepted Iron by "Wit. Map"
- 1976---LCRC #1288---Hackbardt---3/4" Iron: Fence West 43'
15" Pine W 7.9' 18" Pine N45°E 14.3' 20" Oak S50°E 21.8'

P.A. 345 1990 KENT COUNTY
PEER APPROVED 8/22/96
CHAIRMAN *Harry Huber*


B. Description of corner evidence found and/or method applied in restoring or reestablishing corner:

- L-2 Found 3/4" Iron Pipe at top of a ridge from the following witnesses:
Face of 24" Pine West 8'± N-S fence is West 43'±
Face of 30" Pine N55°E 14'± E-W fence is South 7'±
Face of 40" Oak S55°E 21'±
Said 3/4" Iron Pipe is 10.9' N. and 0.6' E. from intersection of 1/4 lines and agrees with survey data of others.

The 3/4" Iron Pipe is accepted by me and is generally accepted by professional surveyors as the best available evidence of the position of the corner.

C. Description of monument for corner and accessories established to perpetuate locating the position of the corner:

- L-2 Set Standard Kent County Monument in place of the 3/4" Iron Pipe
- Set Nail & KC Remon. tag N. side 40" Oak S55°E 22.87'
- Set Nail & KC Remon. tag N. side 30" Pine N55°E 15.52'
- Set Nail & KC Remon. tag N. side 24" Pine N75°W 8.80'
- Set Nail & KC Remon. tag E. side 6" Pine N10°E 42.36'
- N-S fence is West 43'±
- E-W fence is South 7'±

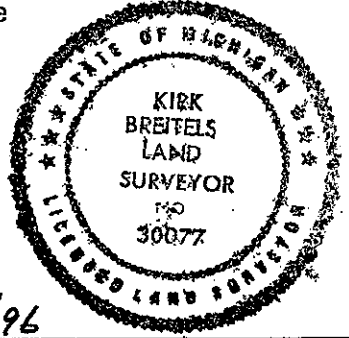

Signed by *Kirk Breitels*
Surveyor's Michigan License No. 30077

Date 9/4/96