

SURVEY & REMONUMENTATION

SEP 18 1995

KENT COUNTY REMONUMENTATION

COMMISSION

LAND CORNER RECORDATION CERTIFICATE

Filing Requirement of Act 74, Mich. P.A. 1970

For corners in
KENT COUNTY
(County)

Located In:

Corner Code #

1. Public Land Survey	T	8N	R	11W	L-4
	T		R		
	T		R		
	T		R		
2. Property Controlling in Section	S		T	R	
	S		T	R	
3. Miscellaneous Property in Section	S		T	R	
	S		T	R	

STATE OF MICHIGAN
COUNTY OF KENT
RECEIVED FOR RECORD

95 AUG 29 AM 10:38

REG. OF DEEDS

Lucy Bond

8679

Register of Deeds Stamp & File Number

4. Lot No. _____, Recorded Plat _____
5. Private Claims _____

A	B	C	D	E	F	G	H	I	J	K	L	M
2	6	5	4	3	2	1						
3												
4	7	8	9	10	11	12						
5												
6	18	17	16	15	14	13						
7												
8	19	20	21	22	23	24						
9												
10	30	29	28	27	26	25						
11												
12	31	32	33	34	35	36						
13												

I, Kirk Breitels, in a field survey on June 12, 1995, do hereby certify that under requirements of P.A. 74, Michigan P.A. of 1970, the corner points mentioned in lines 1 and 2 above were in conformance with regulations and rules therefore as required in the current manual of survey instructions of the United States Department of the Interior, Bureau of Land Management or by a decree of a Court of Law and/or that the corner points mentioned in lines 3, 4 and 5 above were in conformance with the rules of the Michigan Board of Professional Surveyors or by a Decree of a Court of Law; established, re-established, monumented, re-monumented, recovered, found as expressed below:

NOTE: Not more than 4 corners, all in the same town and range, may be recorded on this certificate.

A. Description of original monument and accessories and/or subsequent restoration: P.A. 345 1990 KENT COUNTY
PEER APPROVED 6/22/95
CHAIRMAN Harry Hubert

L-4 1837 GLO Not Set
1953-55 Williams & Works Iron
1957-82 Williams & Works Boat Spike
1982 LCRC #2957 Merdzinski Bt. Spike 1990 LCRC #5630 Brintnall Bt. Spike
16" W. Cherry North 33.30' NE 130.35' 36" Oak
10" Hickory S60°W 49.08' N 33.34' 18" Cherry
NW cor. conc. hdwll. N60°E 26.15' NW 79.48' P.P.
"X" cut S. end culv. S40°E 45.70' SSW 101.84' 26" Oak
On tree line N & fence line S. S60°W 48.77' 12" Hickory


B. Description of corner evidence found and/or method applied in restoring or reestablishing corner:

L-4 Found PK Nail (Road Const. 1993) at the same location as the Boat Spike per 3 remaining witnesses from LCRC #5630 and 1 remaining witness from LCRC #2957. Said PK Nail is 1.0' N. and 13.0' E. of the true "X" intersection of 1/4 lines. Said PK Nail agrees with previous survey data by William R. Byl, Inc. in 1979 and 1994. Also agrees with Williams & Works information. Also fits angles of "Rezen Plat" (Liber 60, Page 14) more or less.

The PK Nail is accepted by me and is generally accepted by professional surveyors as the best available evidence of the position of the corner.

C. Description of monument for corner and accessories established to perpetuate locating the position of the corner:

L-4 Set Standard Kent County Monument in place of the PK Nail.
Set Nail & KC Remon. tag E. side P. Pole S05°W 53.93' (8' high)
Set Nail & KC Remon. tag N. side P. Pole S70°E 161.78' (6' high)
Set Nail & KC Remon. tag S. side 40" Oak N75°E 130.28'
Set Nail & KC Remon. tag E. side 20" Cherry N00°E 33.48'
Nail & KC Rmeon. tag S. side P. Pole N60°W 79.48'
C/L top fire hydrant N20°W 26.58'

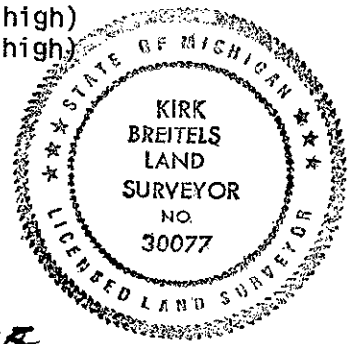

Signed by *Kirk Breitels*
Surveyor's Michigan License No. 30077

Date 8/20/95