

FEB 14 1997

KENT COUNTY REMONUMENTATION

COMMISSION LAND CORNER RECORDATION CERTIFICATE

Filing Requirement of Act 74, Mich. P.A. 1970

For corners in
KENT COUNTY
(County)

Located In:

Corner Code #

1. Public Land Survey	T	<u>8N</u>	R	<u>11W</u>	<u>L-5</u>
	T		R		
	T		R		
	T		R		
2. Property Controlling in Section	S		T	R	
	S		T	R	
3. Miscellaneous Property in Section	S		T	R	
	S		T	R	

STATE OF MICHIGAN
COUNTY OF KENT
RECEIVED FOR RECORD
96 MAR 20 AM 8:59
REG. OF DEEDS
Eric Standish

9117

Register of Deeds Stamp & File Number

4. Lot No. _____, Recorded Plat _____
5. Private Claims _____

A	B	C	D	E	F	G	H	I	J	K	L	M
2	6	5	4	3	2	1						
3												
4	7	8	9	10	11	12						
5												
6	18	17	16	15	14	13						
7												
8	19	20	21	22	23	24						
9												
10	30	29	28	27	26	25						
11												
12	31	32	33	34	35	36						
13												

I, Kirk Breitels, in a field survey on Jan. 16, 1996, do hereby certify that under requirements of P.A. 74, Michigan P.A. of 1970, the corner points mentioned in lines 1 and 2 above were in conformance with regulations and rules therefore as required in the current manual of survey instructions of the United States Department of the Interior, Bureau of Land Management or by a decree of a Court of Law and/or that the corner points mentioned in lines 3, 4 and 5 above were in conformance with the rules of the Michigan Board of Professional Surveyors or by a Decree of a Court of Law; established, re-established, monumented, re-monumented, recovered, found as expressed below:

NOTE: Not more than 4 corners, all in the same town and range, may be recorded on this certificate.

A. Description of original monument and accessories and/or subsequent restoration:

L-5	1837	GLO	Whitcomb	Set Post	P.A. 345 1990 KENT COUNTY
		Kent Co. Wit.		Gas Pipe	PEER APPROVED 3/17/96
	1973	LCRC #451	VanKooten	Nail in Pipe	CHAIRMAN <i>Harry Hester</i>
	1981	LCRC #2572	Bueche	Set Kent County Monument	
	1988	LCRC #4877	Bueche	Kent County Monument	

The position of this corner was previously approved by the Kent County Remonumentation Peer Group, monumented by John C. Bueche on 12/7/81 and was recorded per LCRC #2572.

B. Description of corner evidence found and/or method applied in restoring or reestablishing corner:


L-5 Found standard Kent Co. Mon. (Harrison) per witnesses from above LCRC as set by John C. Bueche in place of the PK Nail over a 1" x 30" Solid Rod he found. Both PK Nail & Solid Rod check with Kent Co. Wit. and LCRC #451.

LCRC #2572			LCRC #4877		
Nail & tag P. Pole	S20°W	39.20'	Nail & tag P. Pole	S19°W	36.31'
Nail & tag 32" W. Cherry	N60°E	42.10'	Nail & tag 32" W. Cherry	N60°E	42.09'
Nail & tag P. Pole	N05°E	79.53'	Nail & tag P. Pole	N05°E	79.53'
Nail & tag 24" Oak	N75°W	115.68'	Nail & tag 24" Oak	N75°W	115.68'
"X" cut on curb	N33°W	57.76'	"X" cut on curb	N33°W	57.73'

The selected location is accepted by me and is generally accepted by professional surveyors as the best available evidence of the position of the original corner.

C. Description of monument for corner and accessories established to perpetuate locating the position of the corner:

L-5	Standard Kent County Monument		
	Nail & KC Remon. tag W. side P. Pole	N05°E	79.53'
	"X" cut on conc. curb	N33°W	57.73'
	Nail & KC Remon. tag E. side P. Pole	S19°W	36.29'
	C/L top of fire hydrant	N80°W	125.81'
	Set Nail & KC Remon. tag S. side 12" Oak	N65°E	81.79'
	N. edge bit. is N. 1'±		

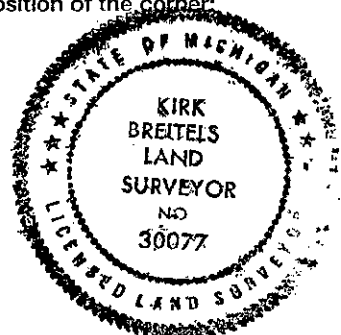

Signed by *Kirk Breitels*
Surveyor's Michigan License No. 30077

Date 2/6/96