

FEB 14 1997

KENT COUNTY REMONUMENTATION

COMMISSION

LAND CORNER RECORDATION CERTIFICATE  
 Filing Requirement of Act 74, Mich. P.A. 1970

For corners in  
KENT COUNTY  
 (County)

Located In:	Corner Code #
T8N R11W	L-6
T R	
T R	
T R	
S T R	
S T R	
S T R	
S T R	

- Public Land Survey
- Property Controlling in Section
- Miscellaneous Property in Sec.

STATE OF MICHIGAN  
 COUNTY OF KENT  
 RECEIVED FOR RECORD

96 SEP 13 PM 12:06

REG. OF DEEDS  
*Lucy D. Land*

9361

Register of Deeds Stamp & File Number

- Lot No. \_\_\_\_\_, Recorded Plat \_\_\_\_\_
- Private Claims \_\_\_\_\_

I, Kirk Breitels, in a field survey on Aug. 15, 1996 do hereby state that under requirements of P.A. 74, Michigan P.A. of 1970, the corner points mentioned in lines 1 and 2 above were in conformance with regulations and rules therefore as required in the current manual of survey instructions of the United States Department of the Interior, Bureau of Land Management or by a decree of a Court of Law and/or that the corner points mentioned in lines 3, 4 and 5 above were in conformance with the rules of the Michigan Board of Land Surveyors or by a Decree of a Court of Law; established, re-established, monumented, recovered, found as expressed below:

	A	B	C	D	E	F	G	H	I	J	K	L	M
1													
2	6	5	4	3	2	1							
3													
4	7	8	9	10	11	12							
5													
6	18	17	16	15	14	13							
7													
8	19	20	21	22	23	24							
9													
10	30	29	28	27	26	25							
11													
12	31	32	33	34	35	36							
13													

NOTE: Not more than 2 corners, all in the same town and range, may be recorded on this certificate.

A. Description of original monument and accessories and/or subsequent restoration:

- L-6 1837---GLO---Not Set
- 1929-73---Williams & Works---Set/Used Iron at intersection 1/4 lines:  
 20" Oak S 27.6' 26" Oak E 33.5' 12" Oak NE 32.3' 12" Hick. W 10.5'
- 1973---LCRC #280---Spicer---1/2" Iron  
 22" Oak S50°E 11.58' 16" Oak N30°E 32.95' 22" Oak S03°W 28.50'  
 14" Hickory W 10.93' On E-W fence & 8' W of fence S
- 1986---Survey---Exxel Eng.---1/2" Iron (Wits. same as LCRC #280)

B. Description of corner evidence found and/or method applied in restoring or reestablishing corner:


- L-6 Found 1/2" Iron Pipe per the following witnesses:  
 26" Oak S50°E 11.6' 20" Oak N30°E 32.9' P.A. 345 1990 KENT COUNTY  
 26" Oak S03°W 28.3' Tw. 14" Hickory W 11.1' PEER APPROVED 8/22/96  
 On E-W fence 8'± W. of fence S CHAIRMAN Harry Huber

Said 1/2" Iron Pipe is 6.2' S. and 0.9' E. from intersection of 1/4 lines and agrees with survey measurements of Williams & Works and Exxel Eng.

The 1/2" Iron Pipe is accepted by me and is generally accepted by professional surveyors as the best available evidence of the position of the corner.

C. Description of monument for corner and accessories established to perpetuate locating the position of the corner:

- L-6 Set Standard Kent County Monument in place of the 1/2" Iron Pipe  
 Spike E. side 26" Oak S03°W 28.33'  
 Spike S. side Tw. 14" Hickory S90°W 11.15'  
 Spike S. side 26" Oak S50°E 11.59'  
 Spike W. side 20" Oak N30°E 32.88'  
 On E-W fence  
 Fence to South is 8'± East

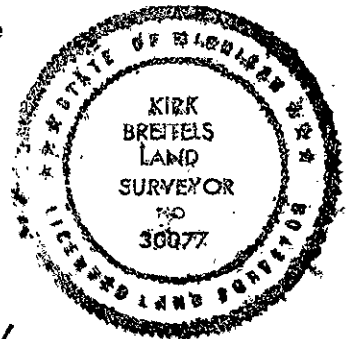

Signed by Kirk Breitels  
 Surveyor's Michigan License No. 30077

Date 9/4/96