

FEB 14 1997

COMMISSION

**KENT COUNTY REMONUMENTATION**

**LAND CORNER RECORDATION CERTIFICATE**  
Filing Requirement of Act 74, Mich. P.A. 1970

For corners in

KENT COUNTY

(County)

Located In:

Corner Code #

1. Public Land Survey	T <u>8N</u> R <u>11W</u>	<u>L-7</u>
	T _____ R _____	_____
	T _____ R _____	_____
	T _____ R _____	_____
2. Property Controlling in Section	S _____ T _____ R _____	_____
	S _____ T _____ R _____	_____
3. Miscellaneous Property in Sec.	S _____ T _____ R _____	_____
	S _____ T _____ R _____	_____

STATE OF MICHIGAN  
COUNTY OF KENT  
RECEIVED FOR RECORD

96 JUN -7 AM 8:29

REG. OF DEEDS

**9194**

Register of Deeds Stamp & File Number

4. Lot No. \_\_\_\_\_, Recorded Plat \_\_\_\_\_  
5. Private Claims \_\_\_\_\_

I, Kirk Breitels, in a field survey on Apr. 17, 1996 do hereby state that under requirements of P.A. 74, Michigan P.A. of 1970, the corner points mentioned in lines 1 and 2 above were in conformance with regulations and rules therefore as required in the current manual of survey instructions of the United States Department of the Interior, Bureau of Land Management or by a decree of a Court of Law and /or that the corner points mentioned in lines 3, 4 and 5 above were in conformance with the rules of the Michigan Board of Land Surveyors or by a Decree of a Court of Law; established, re-established, monumented, recovered, found as expressed below:

NOTE: Not more than 2 corners, all in the same town and range, may be recorded on this certificate.

A	B	C	D	E	F	G	H	I	J	K	L	M
1												
2	6		5		4		3		2		1	
3												
4	7		8		9		10		11		12	
5												
6	18		17		16		15		14		13	
7												
8	19		20		21		22		23		24	
9												
10	30		29		28		27		26		25	
11												
12	31		32		33		34		35		36	
13												

A. Description of original monument and accessories and/or subsequent restoration:

L-7	1837	GLO	Whitcomb	Set Post
	1967	Kent Co. Wit.		"T" Iron
	1973	LCRC #459	Spicer	"T" Iron
	1981	LCRC #2377	Bueche	Set Kent County Monument
	1988	LCRC #4878	Bueche	Kent County Monument

P.A. 345 1990 KENT COUNTY

PEER APPROVED 5/30/96  
CHAIRMAN Harry Huber

The position of this corner was previously approved by the Kent County Remonumentation Peer Group, monumented by John C. Bueche on 11/18/81 and was recorded per LCRC #2377

B. Description of corner evidence found and/or method applied in restoring or reestablishing corner:

L-7 Found standard Kent Co. Mon. (Harrison) per witnesses from above LCRC as set by John C. Bueche in place of the "T" Iron he found. Said "T" Iron checks with Kent Co. Wit. and LCRC #459

<u>LCRC #2377</u>		<u>LCRC #4878</u>	
Nail/tag 12" Ash	N30°W 45.08'	Nail/tag 14" Ash	N30°W 45.25'
Nail/tag 10" Cherry	N10°E 43.54'	Nail/tag 12" Cherry	N10°E 43.63'
Nail/tag 14" Maple	N55°E 69.53'	Nail/tag 16" Maple	N55°E 69.65'
Nail/tag 42" Maple	S70°E 89.60'	Nail/tag 44" Maple	S70°E 89.60'
Nail/tag 26" Maple	N70°W 108.15'	Nail/tag 28" Maple	N70°W 108.15'


The selected location is accepted by me and is generally accepted by professional surveyors as the best available evidence of the position of the original corner.

C. Description of monument for corner and accessories established to perpetuate locating the position of the corner:

L-7 Standard Kent County Monument

New Nail & KC Remon. tag E. side 16" Ash	N30°W	45.00'
New Nail & KC Remon. tag W. side 15" Cherry	N10°E	43.43'
New Nail & KC Remon. tag S. side 18" Maple	N55°E	69.57'
New Nail & KC Remon. tag N. side 46" Maple	S70°E	89.59'
New Nail & KC Remon. tag S. side 30" Maple	N70°W	108.07'
Capped Rerod (Exxel)	North	32.98'

C/L E-W asph. road is North 15'±

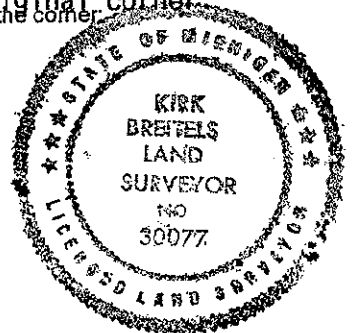

Signed by Kirk Breitels  
Surveyor's Michigan License No. 30077

Date 4/26/96