

**SURVEY & REMONUMENTATION**

MAY 28 1997

COMMISSION

**KENT COUNTY REMONUMENTATION**

**LAND CORNER RECORDATION CERTIFICATE**  
Filing Requirement of Act 74, Mich. P.A. 1970

For corners in  
KENT COUNTY  
(County)

Located In: Corner Code #

1. Public Land Survey	T <u>8</u> N R <u>11</u> W	L-8
	T___ R___	_____
	T___ R___	_____
	T___ R___	_____
2. Property Controlling in Section	S___ T___ R___	_____
	S___ T___ R___	_____
3. Miscellaneous Property in Sec.	S___ T___ R___	_____
	S___ T___ R___	_____

STATE OF MICHIGAN  
COUNTY OF KENT  
RECEIVED FOR RECORD  
95 OCT 18 AM 8:19  
REG. OF DEEDS  
*Luci Steland*

9400

Register of Deeds Stamp & File Number

4. Lot No. \_\_\_\_\_, Recorded Plat \_\_\_\_\_  
5. Private Claims \_\_\_\_\_

I, Kirk Breitels, in a field survey on Sept. 9, 1996 do hereby state that under requirements of P.A. 74, Michigan P.A. of 1970, the corner points mentioned in lines 1 and 2 above were in conformance with regulations and rules therefore as required in the current manual of survey instructions of the United States Department of the Interior, Bureau of Land Management or by a decree of a Court of Law and /or that the corner points mentioned in lines 3, 4 and 5 above were in conformance with the rules of the Michigan Board of Land Surveyors or by a Decree of a Court of Law; established, re-established, monumented, recovered, found as expressed below:

NOTE: Not more than 2 corners, all in the same town and range, may be recorded on this certificate.

A	B	C	D	E	F	G	H	I	J	K	L	M
1												
2	6		5		4		3		2		1	
3												
4	7		8		9		10		11		12	
5												
6	18		17		16		15		14		13	
7												
8	19		20		21		22		23		24	
9												
10	30		29		28		27		26		25	
11												
12	31		32		33		34		35		36	
13												

A. Description of original monument and accessories and/or subsequent restoration:

- L-8 1837---GL0---Not Set
- 1952-64---Williams & Works---Set/Used Iron at intersection of 1/4 lines
- Kent Co. Wit.---Iron
- 1976---LCRC #965---Bonnema---Set 3/4" Iron at intersection of 1/4 lines


B. Description of corner evidence found and/or method applied in restoring or reestablishing corner:

L-8 Found area of C 1/4 corner to be in construction area. Computed intersection of 1/4 lines agrees with survey measurements of others.

The Intersection of 1/4 lines is accepted by me and is generally accepted by professional surveyors as the best available evidence of the position of the corner.

C. Description of monument for corner and accessories established to perpetuate locating the position of the corner:

L-8 NO KENT CO. MON. SET  
See LCRC # 9399 for location of witness monument.

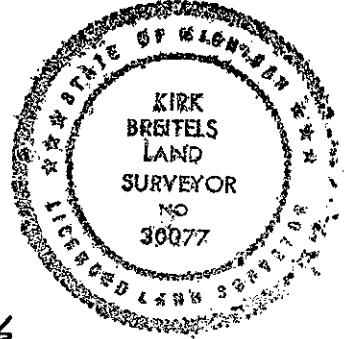

Signed by *Kirk Breitels*  
Surveyor's Michigan License No. 30077

Date 10/11/96

P.A. 345 1990 KENT COUNTY  
PEER APPROVED 9/26/96  
CHAIRMAN *Harry Huber*