

SURVEY & REMONUMENTATION

FEB 14 1997
COMMISSION

KENT COUNTY REMONUMENTATION

LAND CORNER RECORDATION CERTIFICATE
Filing Requirement of Act 74, Mich. P.A. 1970

For corners in
KENT COUNTY

(County)

Located In:

Corner Code #

1. Public Land Survey

T 8N R 11W

L-9

2. Property Controlling in Section

S

T R

3. Miscellaneous Property in Sec.

S

T R

S

T R

S

T R

4. Lot No. _____ Recorded Plat _____
5. Private Claims _____

REG. OF DEEDS

96 JUN -7 AM 8:29

STATE OF MICHIGAN
COUNTY OF KENT
RECEIVED FOR RECORD

9195

Register of Deeds Stamp & File Number

	A	B	C	D	E	F	G	H	I	J	K	L	M
1													
2	6	5	4	3	2	1							
3													
4	7	8	9	10	11	12							
5													
6	13	17	16	15	14	13							
7													
8	19	20	21	22	23	24							
9													
10	30	29	28	27	26	25							
11													
12	31	32	33	34	35	36							
13													

P.A. 345 1990 KENT COUNTY

PEER APPROVED 5/30/96

CHAIRMAN *[Signature]*
Set Post
Set 1/2" Rerod
Set 1/2" Rerod (LCRC #1310-incorrect)
Set Kent County Monument in swampy area
Kent County Monument

I, Kirk Breitels, in a field survey on Apr. 10, 1996 do hereby state that under requirements of P.A. 74, Michigan P.A. of 1970, the corner points mentioned in lines 1 and 2 above were in conformance with regulations and rules therefore as required in the current manual of survey instructions of the United States Department of the Interior, Bureau of Land Management or by a decree of a Court of Law and/or that the corner points mentioned in lines 3, 4 and 5 above were in conformance with the rules of the Michigan Board of Land Surveyors or by a Decree of a Court of Law, established, re-established, monumented, recovered, found as expressed below:

NOTE: Not more than 2 corners, all in the same town and range, may be recorded on this certificate.

A. Description of original monument and accessories and/or subsequent restoration:

L-9 1837 GLO
1979 LCRC #1310
1981 LCRC #2312
1982 LCRC #2669
1988 LCRC #4879

Whitcomb
Nederveld
Nederveld
Bonnema
Bueche

The position of this corner was previously approved by the Kent County Remonumentation Peer Group, monumented by Douglas W. Bonnema on 1/12/82 and was recorded per LCRC #2669

B. Description of corner evidence found and/or method applied in restoring or reestablishing corner:

L-9 Found standard Kent Co. Mon. (Harrison) per witnesses from above LCRC as set by Douglas W. Bonnema at the location described per LCRC. LCRC #1310 & #2312 not at this location.

LCRC #2669 & #4879

Nail in W. side 26" Willow S20°E 79.81' L-9 as determined in
Nail & KC Remon. tag SW side 10" Maple N31°W 8.89' LCRC #2312 is
Nail & KC Remon. tag S. side 10" Maple S89°W 43.68' South 71.36'
Nail in N. side 10" Maple N58°E 45.07'
Nail & KC Remon. tag N. side 12" Elm N58°E 45.07'


The selected location is accepted by me and is generally accepted by professional surveyors as the best available evidence of the position of the original corner.

C. Description of monument for corner and accessories established to perpetuate locating the position of the corner:

L-9 Standard Kent County Monument

Set Nail & KC Remon. tag E. side 32" Willow S20°E 80.64'
New Nail & KC Remon. tag SW side 12" Maple N31°W 9.03'
New Nail & KC Remon. tag S. side 12" Maple S89°W 43.48'
Set Nail & KC Remon. tag N. side 16" Maple S52°W 35.37'
Set Nail & KC Remon. tag SE side 10" Ash N30°E 33.39'

NOTE: Conc. blocks around monument - still loose in swamp

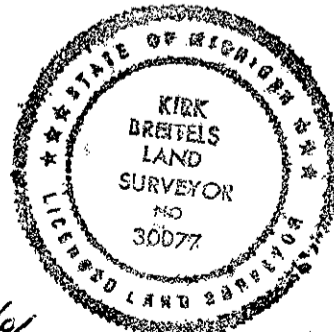

Signed by *[Signature]*
Surveyor's Michigan License No. 30077

Date 4/26/96