
FEB 1 4 1997

COMMISSION

KENT COUNTY REMONUMENTATION

. J. 679 86	00000000000000000000000000000000000000										
		D CORNER RECORDATION CE						۲O.			
or corners in	1 4111	ing incorporation of Mot 14, Mich.	. F.M. 197	•		77	1	<u> </u>	~	(4)	
KENT COUNTY	Located In:	Corner Code #								53.4	
(County)	₽	Johns Gada II				a /		8	82	irn Go	
1. Public Land Survey	T <u>8N</u> R T <u>8N</u> R TR	10W A 10			(((三 9:	FOR RECO!		
2. Property Controlling in Section 3. Miscellaneous	S TR S TR S T R			91	127	,		<u>ප</u> ි ්	<u></u>	- <i>V</i> .	•
Property in Sec.	S TR				_		eds St	tamp &	File	Num	ber
I. Lot No, Recor 5. Private Claims	ded Plat	C PR 18 T minutes		1 A 1 2 A 3	B C	D E	F (3 H	I J	ĸ	L M
equirements of P.A. 74, Michiga onformance with regulations and Inited States Department of the I nat the corner points mentioned	in P.A. of 1970, the com rules therefore as require nterior, Bureau of Land M in lines 3, 4 and 5 above a Decree of a Court of	Jan. 23, 19 96 do hereby state the ner points mentioned in lines 1 and 2 above red in the current manual of survey instructions wanagement or by a decree of a Court of Law were in conformance with the rules of the North Law; established, re-established, monu	e were in ons of the w and /or Michigan	4 - 5 - 6 - 1 7 - 8 - 1	8	-17		15-	11		-12 -13 -24
IOTE: Not more than 2 com	ers. all in the same tow	vn and range, may be recorded		9		-			-	\perp	
on this certificate.		A. 345 1990 KENT COUNTY		10 -3	0	_29 !	28	27 <u>—</u> 27—	26 26	, 	25 -
	PE	EER APPROYES 3/7/94		11		$\dashv \dashv$	-		++	+	+

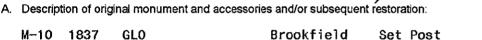

1981	LCRC #1955	Bonnema	3/4" Solid Iron
1983	LCRC #3215	Stadt	Set Kent County Monument
1988	LCRC #4890	Bueche	Kent County Monument

The position of this corner was previously approved by the Kent County Remonumentation Peer Group, monumented by Russell E. Stadt on 3/2/83 and was recorded per LCRC #3215.

y Mushell

B. Description of corner evidence found and/or method applied in restoring or reestablishing corner:

M-10 Found standard Kent Co. Mon. (Harrison) per witnesses from above LCRC as set by Russell E. Stadt in place of the 3/4" Solid Iron he found. Said Iron checks with LCRC #3215 and previous survey data. LCRC #3215 & #4890

Nail & KC Remon. tag E. side 8" Box Elder Nail & KC Remon. tag SE side 10" Box Elder Nail & KC Remon. tag SW side 50" Maple N-S wire fence is 3' W. North 33.68 20.21' N45°W N. bank Bear Creek is S40°E 132' S. 31.03' Nail & KC Remon. tag S. side 8" Box Elder West 5.36' C/L bit. N-E is N. 300'± Nail & KC Remon. tag S. side 6" Ash S85°E 54.12'
The selected location is accepted by me and is generally accepted by professional C/L bit. N-E is N. 300'±

c. surveyors as the best available evidence of the position of the original corner.

M-10 Standard Kent County Monument

New Nail & KC Remon. tag E. side 14" Box Elder North 33.63 New Nail & KC Remon. tag SE side 15" Box Elder 20.11' N45°E New Nail & KC Remon. tag SW side 54" Maple 31.11' S40°E New Nail & KC Remon. tag S. side 8" Ash NW cor. wood "tombstone" S85°E 54.17' 8.83' \$05°E

N-S wire fence is 3' W., 2nd N-S fence is 5' W. N. bank Bear Creek is $125' \pm S$. C/L bit. N-E is N. $300' \pm$

16/96 Surveyor's Michigan License No.

OF MICH