

SURVEY & REMONUMENTATION

KENT COUNTY REMONUMENTATION

FEB 14 1997

LAND CORNER RECORDATION CERTIFICATE
Filing Requirement of Act 74, Mich. P.A. 1970

"other" code #21
96 OCT 18 AM 8:19
REG. OF DEEDS
STATE OF MICHIGAN
COUNTY OF KENT
RECEIVED FOR RECORD

COMMISSION
For corners in
KENT COUNTY
(County)

Located In:	Corner Code #
1. Public Land Survey	T _____ R _____
	T _____ R _____
	T _____ R _____
	T _____ R _____
2. Property Controlling in Section	S 24 T 8N R 11W S _____ T _____ R _____
3. Miscellaneous Property in Section	S _____ T _____ R _____ S _____ T _____ R _____
	Wit. Mon. on E-W 1/4 line Sec. 24

9399

Register of Deeds Stamp & File Number

4. Lot No. _____, Recorded Plat _____
5. Private Claims _____

	A	B	C	D	E	F	G	H	I	J	K	L	F
2	0		5		4		3		2				
3													
4	7		8		9		10		11		12		
5													
6	18		17		16		15		14		13		
7													
8	19		20		21		22		23		24		
9													
10	30		29		28		27		26		25		
11													
12	31		32		33		34		35		36		
13													

I, Kirk Breitels, in a field survey on Sept. 9, 1996, do hereby certify that under requirements of P.A. 74, Michigan P.A. of 1970, the corner points mentioned in lines 1 and 2 above were in conformance with regulations and rules therefore as required in the current manual of survey instructions of the United States Department of the Interior, Bureau of Land Management or by a decree of a Court of Law and/or that the corner points mentioned in lines 3, 4 and 5 above were in conformance with the rules of the Michigan Board of Professional Surveyors or by a Decree of a Court of Law; established, re-established, monumented, re-monumented, recovered, found as expressed below:

NOTE: Not more than 4 corners, all in the same town and range, may be recorded on this certificate.

A. Description of original monument and accessories and/or subsequent restoration:

1837 GLO Not set

B. Description of corner evidence found and/or method applied in restoring or reestablishing corner:


Established property corner on the E-W 1/4 line of Sec. 24, per Williams and Works and Exxel Engineering surveys at the SE corner of the West 1/2 of the W 1/2 of the NE 1/4 of Sec. 24 (C 1/4 corner = intersection of 1/4 lines). Found "T" Iron to be within 0.1' of this corner and found Exxel capped rerod to be with 0.3' of this corner.

SEE LCRC # 9400 FOR INFORMATION FOR THE C 1/4 CORNER

C. Description of monument for corner and accessories established to perpetuate locating the position of the corner:

Set Standard Kent Co. Witness Monument at the location described above

- Set Nail & KC Remon. tag E. side 48" Oak S20°W 18.78'
- Set Nail & KC Remon. tag SE side 12" Cherry S60°W 26.27'
- Set Nail & KC Remon. tag E. side 24" Oak N10°W 17.61'
- Set Nail & KC Remon. tag S. side 10" Elm S75°E 33.45'

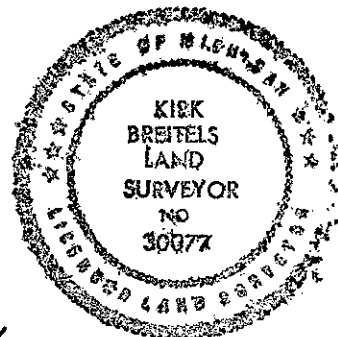

Signed by Kirk Breitels

Date 10/11/96

Surveyor's Michigan License No. 30077

FORM APPROVED BY MICHIGAN STATE BOARD OF PROFESSIONAL SURVEYORS, JAN. 28, 1971
REVISED MAY 14, 1972
REVISED JAN., 1987

P.A. 345 1990 KENT COUNTY
PEER APPROVED 9/26/96
CHAIRMAN [Signature]