SURVEY & REMONUMENTATION

FEB 1 4 1997

COMMISSION

KENT COUNTY REMONUMENTATION

LAND CORNER RECORDATION CERTIFICATE

Filing Requirement of Act 74, Mich. P.A. 1970

STATE OF MICHIGAN COUNTY OF KENT RECEIVED FOR RECORD 96 MAR 20 AM 8:55 REG. OF DEEDS

9048

Register of Deeds Stamp & File Number

For corners in KENT COUNTY (County)

	Located In:	Corner Code #
1. Public Land Survey	T ___ R ___	#2
	T ___ R ___	
	T ___ R ___	
	T ___ R ___	
2. Property Controlling	S 29 T 8N R 11W	Wit. Mon. on
in Section	S ___ T ___ R ___	E-W 1/4 line
3. Miscellaneous	S ___ T ___ R ___	Sec. 29
Property in Section	S ___ T ___ R ___	

4. Lot No. _____, Recorded Plat _____
5. Private Claims _____

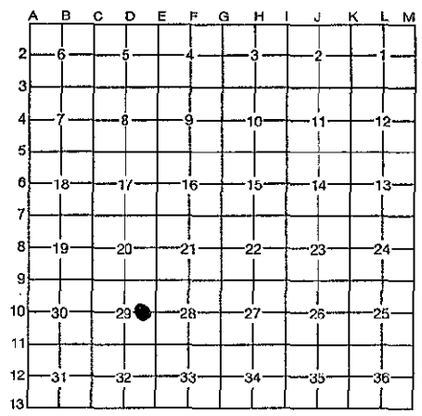

I, Kirk Breitels, in a field survey on Jan. 26, 19 96, do hereby certify that under requirements of P.A. 74, Michigan P.A. of 1970, the corner points mentioned in lines 1 and 2 above were in conformance with regulations and rules therefore as required in the current manual of survey instructions of the United States Department of the Interior, Bureau of Land Management or by a decree of a Court of Law and/or that the corner points mentioned in lines 3, 4 and 5 above were in conformance with the rules of the Michigan Board of Professional Surveyors or by a Decree of a Court of Law; established, re-established, monumented, re-monumented, recovered, found as expressed below:

NOTE: Not more than 4 corners, all in the same town and range, may be recorded on this certificate.

A. Description of original monument and accessories and/or subsequent restoration:

1837	GLO		Not set
1992	LCRC #6647	Marschall	Set Kent County Witness Monument on E-W 1/4 line 302.00' East of the C 1/4 corner of Sec. 29.

The position of this corner was previously approved by the Kent County Remonumentation Peer Group, monumented (Witness Monument) by Chris Marschall on 11/2/92 and was recorded per LCRC #6647.

B. Description of corner evidence found and/or method applied in restoring or reestablishing corner:

Found Standard Kent County Witness Monument per witnesses from above LCRC as set by Chris Marschall.

LCRC #6647

Nail & KC Remon. tag W. side 12" Ash	N30°W	6.82'
Nail & KC Remon. tag S. side 12" Ash	N85°E	26.46'
Nail & KC Remon. tag NW side 32" Oak	N60°E	20.63'

N. edge of plowed field is South 10'±
Angle point of plowed field is West 50'±

P.A. 345 1990 KENT COUNTY
PEER APPROVED 3/7/96
CHAIRMAN Harry Huber

The selected location is accepted by me and is generally accepted by professional surveyors as the best available location of the corner.

C. Description of monument for corner and accessories established to perpetuate locating the position of the corner:

Standard Kent Co. Witness Monument

Nail & KC Remon. tag W. side 12" Ash	N30°W	6.82'
Nail & KC Remon. tag S. side 12" Ash	N85°E	26.46'
Nail & KC Remon. tag NW side 32" Oak	N60°E	20.63'
Set Nail & KC Remon. tag E. side Tri. 18" Oak	N15°E	32.69'

N. edge of plowed field is South 10'±
Angle point of plowed field is West 50'±

STATE OF MICHIGAN KIRK BREITELS LAND SURVEYOR NO. 30077 LICENSED LAND SURVEYOR

Signed by Kirk Breitels Date 2/6/96

Surveyor's Michigan License No. 30077

FORM APPROVED BY MICHIGAN STATE BOARD OF PROFESSIONAL SURVEYORS, JAN. 28, 1971
REVISED MAY 14, 1975
REVISED JAN., 1983