

**SURVEY & REMONUMENTATION**

SEP 18 1995  
\$7.00  
\$2.00  
COMMISSION

**KENT COUNTY REMONUMENTATION**

**LAND CORNER RECORDATION CERTIFICATE**  
Filing Requirement of Act 74, Mich. P.A. 1970

For corners in  
**KENT COUNTY**  
(County)

Located In:	Corner Code #
T <u>8N</u> R <u>12W</u>	<u>A-2</u>
T _____ R _____	_____
T _____ R _____	_____
T _____ R _____	_____
T _____ R _____	_____
2. Property Controlling in Section S _____ T _____ R _____	_____
S _____ T _____ R _____	_____
3. Miscellaneous S _____ T _____ R _____	_____
Property in Sec. S _____ T _____ R _____	_____

REG. OF DEEDS

*Lucy Bond*

95 JUN 29 AM 11:50

STATE OF MICHIGAN  
COUNTY OF KENT  
RECEIVED FOR RECORD

8418

Register of Deeds Stamp & File Number

4. Lot No. \_\_\_\_\_, Recorded Plat \_\_\_\_\_  
5. Private Claims \_\_\_\_\_

	A	B	C	D	E	F	G	H	I	J	K	L	M
2	6	5	4	3	2	1							
3													
4	7	8	9	10	11	12							
5													
6	18	17	16	15	14	13							
7													
8	19	20	21	22	23	24							
9													
10	30	29	28	27	26	25							
11													
12	31	32	33	34	35	36							
13													

I, Kirk Breitels, in a field survey on Feb. 7, 1995, do hereby certify that under requirements of P.A. 74, Michigan P.A. of 1970, the corner points mentioned in lines 1 and 2 above were in conformance with regulations and rules therefore as required in the current manual of survey instructions of the United States Department of the Interior, Bureau of Land Management or by a decree of a Court of Law and/or that the corner points mentioned in lines 3, 4 and 5 above were in conformance with the rules of the Michigan Board of Land Surveyors or by a Decree of a Court of Law; established, re-established, monumented, re-monumented, recovered, found as expressed below:

**NOTE: Not more than 4 corners, all in the same town and range, may be recorded on this certificate.**

**A. Description of original monument and accessories and/or subsequent restoration:**

A-2	1837	GLO	Brookfield	Set Post
	1944	Kent Co. Wit.		Conc. Mon.
	1951	Williams & Works		Set point from witnesses
		LCRC L. 3, Pg. 68-Ottawa Co.		Cast Iron Mon. (common corner)
	1984	LCRC #4169	Bueche	Found Ottawa Co. Cast Iron Mon.
	1992	LCRC #6571	Marschall	Set Kent Co. Mon. (Ott. Co. mon. broken)

The position of this corner was previously approved by the Kent County Remonumentation Peer Group, recorded by John C. Bueche on 11/8/84 and was recorded per LCRC #4169.

**B. Description of corner evidence found and/or method applied in restoring or reestablishing corner:**

A-2 Found standard Kent Co. Mon. (Harrison) per witnesses from above LCRC as set by Chris Marschall in place of the broken Ottawa Co. Mon. (LCRC #4169) he found over top of a conc. mon. Said broken Ottawa Co. Mon. and conc. mon. checks with Kent Co. Wit., Williams & Works information and LCRC Liber 3, Pg. 68 Ottawa Co. Records.

**LCRC #6571**

Nail & tag SW side 24" Walnut	N35°W	33.20'
Nail & tag E. side 26" Walnut	S20°W	101.46'
Nail & tag N. side P. Pole	N89°W	149.92'
Nail & tag E. side P. Pole	N20°E	163.41'

P.A. 345 1990 KENT COUNTY

PEER APPROVED


CHAIRMAN

*Stan Hubel*  
6/22/95

The selected location is accepted by me and is generally accepted by professional surveyors as the best available evidence of the position of the original corner.

**C. Description of monument for corner and accessories established to perpetuate locating the position of the corner:**

A-2 Standard Kent County Monument			
Nail & KC Remon. tag SW side 24" Walnut	N35°W	33.25'	
New Nail & KC Remon. tag E. side 26" Walnut	S20°W	101.52'	
Nail & KC Remon. tag N. side P. Pole	N89°W	150.02'	
Nail & KC Remon. tag E. side P. Pole	N20°E	163.41'	
Cut "X" top conc. curb	S60°E	25.25'	

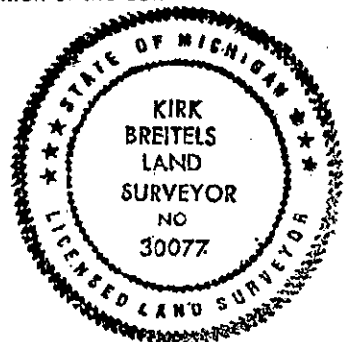

Signed by *Kirk Breitels*

Date 6/22/95

Surveyor's Michigan License No. 30077