

\$7.00
\$2.00 SEP 18 1995
COMMISSION

KENT COUNTY REMONUMENTATION

LAND CORNER RECORDATION CERTIFICATE
Filing Requirement of Act 74, Mich. P.A. 1970

For corners in
KENT COUNTY
(County)

Located In:	Corner Code #
1. Public Land Survey T 8N R 12W	A-5
T R	
T R	
T R	
2. Property Controlling S T R	
in Section S T R	
3. Miscellaneous S T R	
Property in Sec. S T R	

STATE OF MICHIGAN
COUNTY OF KENT
RECEIVED FOR RECORD
95 JUN 29 AM 11:50
REG. OF DEEDS
Luc Standa
8420
Register of Deeds Stamp & File Number

- 4. Lot No. _____, Recorded Plat _____
- 5. Private Claims _____

	A	B	C	D	E	F	G	H	I	J	K	L	M
2	6	5	4	3	2	1							
3													
4	7	8	9	10	11	12							
5													
6	18	17	16	15	14	13							
7													
8	19	20	21	22	23	24							
9													
10	30	29	28	27	26	25							
11													
12	31	32	33	34	35	36							
13													

I, Kirk Breitels, in a field survey on Feb. 7, 19 95, do hereby certify that under requirements of P.A. 74, Michigan P.A. of 1970, the corner points mentioned in lines 1 and 2 above were in conformance with regulations and rules therefore as required in the current manual of survey instructions of the United States Department of the Interior, Bureau of Land Management or by a decree of a Court of Law and/or that the corner points mentioned in lines 3, 4 and 5 above were in conformance with the rules of the Michigan Board of Land Surveyors or by a Decree of a Court of Law; established, re-established, monumented, re-monumented, recovered, found as expressed below:

NOTE: Not more than 4 corners, all in the same town and range, may be recorded on this certificate.

A. Description of original monument and accessories and/or subsequent restoration:

A-5	1837	GLO	Brookfield	Set Post
	1935	Kent Co. Wit.		Conc. Mon.
	1966	Ottawa Co. Wit.		Iron
	1984		Bueche	Conc. Mon.
	1985	LCRC #4320	Bueche	Found Ottawa Co. Monument

The position of this corner was previously approved by the Kent County Remonumentation Peer Group, recorded by John C. Bueche on 11/29/85 and was recorded per LCRC #4320.

B. Description of corner evidence found and/or method applied in restoring or reestablishing corner:

A-5 Found standard Ottawa Co. Mon. per witnesses from above LCRC as recorded by John C. Bueche. Said Ottawa Co. Mon. checks with Kent Co. Wit. and Ottawa Co. Wit.

LCRC #4320

Nail & RLS tag 18043 NW side service pole	N50°E	69.96'
Nail & RLS tag 18043 N. side P. Pole	S55°E	53.07'
Nail & RLS tag 18043 S. side P. Pole	S65°W	91.86'
Top C/L of MBT box	N50°W	63.00'
C/L gravel rd. N. is East 3' m/l		


P.A. 3.5 1979 KENT COUNTY
PEER APPROVED 6/22/95
CHAIRMAN John C. Bueche

The selected location is accepted by me and is generally accepted by professional surveyors as the best available evidence of the position of the original corner.

C. Description of monument for corner and accessories established to perpetuate locating the position of the corner:

A-5 Standard Ottawa County Monument

Nail & RLS tag 18435 NW side service pole	N50°E	69.96'
Nail & KC Remon. tag N. side P. Pole.	S55°E	53.22'
Nail & KC Remon. tag S. side P. Pole	S65°W	91.87'
Top C/L of MBT box	N50°W	63.00'
C/L gravel rd. N. is East 3' m/l		

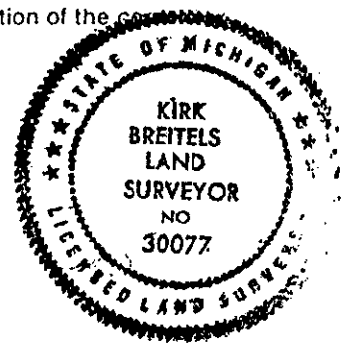

Signed by Kirk Breitels
Surveyor's Michigan License No. 30077

Date 6/22/95