

**SURVEY & REMONUMENTATION**  
 \$7.00 SEP 18 1995  
 \$2.00 COMMISSION

**KENT COUNTY REMONUMENTATION**

**LAND CORNER RECORDATION CERTIFICATE**  
 Filing Requirement of Act 74, Mich. P.A. 1970

For corners in  
**KENT COUNTY**  
 (County)

Located In:	Corner Code #
T 8N R 12W	A-6
T R	
T R	
T R	
T R	
S T R	
S T R	
S T R	
S T R	

STATE OF MICHIGAN  
 COUNTY OF KENT  
 RECEIVED FOR RECORD  
 95 JUN 29 AM 11:51  
 REG. OF DEEDS  
*Eric J. Stand*

**8421**

Register of Deeds Stamp & File Number

- Public Land Survey
- Property Controlling in Section
- Miscellaneous Property in Sec.
- Lot No. \_\_\_\_\_, Recorded Plat \_\_\_\_\_
- Private Claims \_\_\_\_\_

	A	B	C	D	E	F	G	H	I	J	K	L	M
2	6	5	4	3	2								
3													
4	7	8	9	10	11	12							
5													
6	18	17	16	15	14	13							
7													
8	19	20	21	22	23	24							
9													
10	30	29	28	27	26	25							
11													
12	31	32	33	34	35	36							
13													

I, Kirk Breitels, in a field survey on Feb. 7, 1995, do hereby certify that under requirements of P.A. 74, Michigan P.A. of 1970, the corner points mentioned in lines 1 and 2 above were in conformance with regulations and rules therefore as required in the current manual of survey instructions of the United States Department of the Interior, Bureau of Land Management or by a decree of a Court of Law and/or that the corner points mentioned in lines 3, 4 and 5 above were in conformance with the rules of the Michigan Board of Land Surveyors or by a Decree of a Court of Law; established, re-established, monumented, re-monumented, recovered, found as expressed below:

**NOTE: Not more than 4 corners, all in the same town and range, may be recorded on this certificate.**

**A. Description of original monument and accessories and/or subsequent restoration:**

A-6	1837	GLO	Brookfield	Set Post
	1935	Kent Co. Wit.		Conc. Mon.
		Ottawa Co. Wit.		Conc. Mon.
	1985	LCRC #4321	Bueche	Set Kent County Monument
	1991	LCRC #5732	Bueche	Reset Kent County Monument

The position of this corner was previously approved by the Kent County Remonumentation Peer Group, monumented by John C. Bueche on 11/29/85 and was recorded per LCRC #4321

**B. Description of corner evidence found and/or method applied in restoring or reestablishing corner:**

A-6 Found standard Kent Co. Mon. (Harrison) per witnesses from above LCRC as set by John C. Bueche in same place as set in 1985 in place of the conc. mon. he found. Said conc. mon. checks with Kent Co. Wit. and Ottawa Co. Wit.

LCRC #5732

Nail & Remon. tag E. side 16" Poplar	N00°E	61.23'	
Nail & Remon. tag E. side 12" Oak	N25°W	56.27'	(4.5' high)
Nail & Remon. tag SW side 36" Beech	N50°W	91.84'	
Nail in face of P. Pole	N70°E	118.34'	
On C/L blacktop E-W			

P.A. 345 1990 KENT COUNTY


PEER APPROVED 6/22/95  
 CHAIRMAN Harry Huber

The selected location is accepted by me and is generally accepted by professional surveyors as the best available evidence of the position of the original corner.

**C. Description of monument for corner and accessories established to perpetuate locating the position of the corner:**

**A-6 Standard Kent County Monument**

New Nail & Remon. tag E. side 20" Poplar	N00°E	60.86'	
New Nail & Remon. tag E. side 18" Oak	N25°W	56.34'	(4.5' high)
Nail & Remon. tag SW side 36" Beech	N50°W	91.84'	
Nail in face of P. Pole	N70°E	118.34'	
C/L W. end bolt to tree support	S25°W	31.10'	
On C/L blacktop E-W			

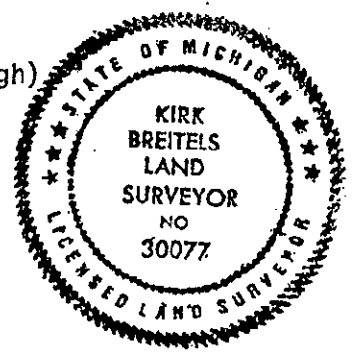

Signed by *Kirk Breitels*

Date 6/22/95

Surveyor's Michigan License No. 30077