

SURVEY & REMONUMENTATION

SEP 03 1999

KENT COUNTY REMONUMENTATION

LAND CORNER RECORDATION CERTIFICATE

Filing Requirement of Act 74, Mich. P.A. 1970

STATE OF MICHIGAN
COUNTY OF KENT
RECEIVED FOR RECORD

94 NOV 28 AM 11:42

For corners in SECTION
KENT COUNTY
(County)

Located In: Corner Code #

- | | | | | | |
|------------------------------------|---|----|---|-----|--------|
| 1. Public Land Survey | T | 7N | R | 12W | A-1 |
| | T | | R | | |
| | T | 8N | R | 12W | A-13 ✓ |
| | T | | R | | |
| 2. Property Controlling in Section | S | | T | R | |
| | S | | T | R | |
| 3. Miscellaneous Property in Sec. | S | | T | R | |
| | S | | T | R | |

Lee J. Bond
REG. OF DEEDS

7268

Register of Deeds Stamp & File Number

4. Lot No. _____, Recorded Plat _____
5. Private Claims _____

A	B	C	D	E	F	G	H	I	J	K	L	M
2	6	5	4	3	2	1						
3												
4	7	8	9	10	11	12						
5												
6	18	17	16	15	14	13						
7												
8	19	20	21	22	23	24						
9												
10	30	29	28	27	26	25						
11												
12	31	32	33	34	35	36						
13												

I, William R. Byl, in a field survey on July 1, 1994, do hereby certify that under requirements of P.A. 74, Michigan P.A. of 1970, the corner points mentioned in lines 1 and 2 above were in conformance with regulations and rules therefore as required in the current manual of survey instructions of the United States Department of the Interior, Bureau of Land Management or by a decree of a Court of Law and/or that the corner points mentioned in lines 3, 4 and 5 above were in conformance with the rules of the Michigan Board of Land Surveyors or by a Decree of a Court of Law; established, re-established, monumented, re-monumented, recovered, found as expressed below:

NOTE: Not more than 4 corners, all in the same town and range, may be recorded on this certificate.

A. Description of original monument and accessories and/or subsequent restoration:

A-1	1837	GLO	Brookfield	Set Post
	1960	Kent Co. Wit.	MDSH	3/4" Iron
	1975	LCRC #803	Ruzzala	1/2" Bar
	1982	LCRC #3166	Jonker	Set Kent County Monument

The position of this corner was previously approved by the Kent County Remonumentation Peer Group, monumented by Robert J. Jonker on 10/11/82 and was recorded per LCRC #3166.

B. Description of corner evidence found and/or method applied in restoring or reestablishing corner:

A-1 Found standard Kent Co. Mon. (Harrison) per witnesses from above LCRC as set by Robert J. Jonker in place of the 3/4" Iron, 2 boat spikes angled over stone with lead plug he found. Said 3/4" Iron, boat spikes and stone check with Kent Co. Wit. and LCRC #803.

LCRC #3166

Remon. tag S. side P. Pole	N75°E	95.0'
Remon. tag SW side 40" Catalpa	N40°W	47.04'
Remon. tag SE side 3" Maple	S45°W	41.3'
Set chiseled "X" on C/L H/W	N10°W	67.58'
Set chiseled "X" on C/L H/W	N15°E	67.45'
Iron in Ottawa Co. mon. box	West	65.75'
C/L pavement is 1.7' South		

P.A. 345 1970 KENT COUNTY

PEER APPROVED 11/17/99


CHAIRMAN *Harry Huber*

The selected location is accepted by me and is generally accepted by professional surveyors as the best available evidence of the position of the original corner.

C. Description of monument for corner and accessories established to perpetuate locating the position of the corner:

A-1 Standard Kent County Monument

Nail & KC Remon. tag S. side P. Pole	N75°E	94.91'
New Nail & KC Remon. tag SW side 44" Catalpa	N40°W	47.08'
New Nail & KC Remon. tag SE side 6" Maple	S45°W	41.31'
Chiseled "X" on C/L H/W	N10°W	67.45'
Chiseled "X" on C/L H/W	N15°E	67.40'
Iron in Ottawa Co. mon. box	West	65.75'
Set Nail & KC Remon. tag N. side 14" Tree	S65°E	92.78'
C/L pavement is 1.7' South		

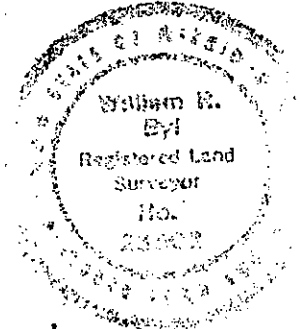

Signed by *William R. Byl*
Surveyor's Michigan License No. 23502

Date 11-17-99