

JAN 24 1996

KENT COUNTY REMONUMENTATION

COMMISSION LAND CORNER RECORDATION CERTIFICATE

Filing Requirement of Act 74, Mich. P.A. 1970

\$7.00  
\$2.00

For corners in  
KENT COUNTY  
(County)

Located In:

Corner Code #

1. Public Land Survey	T	8N	R	12W	B-2
	T		R		
	T		R		
	T		R		
2. Property Controlling in Section	S		T	R	
	S		T	R	
3. Miscellaneous Property in Section	S		T	R	
	S		T	R	

STATE OF MICHIGAN  
COUNTY OF KENT  
RECEIVED FOR RECORD  
95 DEC 20 AM 8:36  
REG. OF DEEDS  
8768

Register of Deeds Stamp & File Number

4. Lot No. \_\_\_\_\_, Recorded Plat \_\_\_\_\_  
5. Private Claims \_\_\_\_\_

A	B	C	D	E	F	G	H	I	J	K	L	M
2	6		5		4		3		2		1	
3												
4	7		8		9		10		11		12	
5												
6	18		17		16		15		14		13	
7												
8	19		20		21		22		23		24	
9												
10	30		29		28		27		26		25	
11												
12	31		32		33		34		35		36	
13												

I, Kirk Breitels, in a field survey on Oct. 23, 1995

do hereby certify that under requirements of P.A. 74, Michigan P.A. of 1970, the corner points mentioned in lines 1 and 2 above were in conformance with regulations and rules therefore as required in the current manual of survey instructions of the United States Department of the Interior, Bureau of Land Management or by a decree of a Court of Law and/or that the corner points mentioned in lines 3, 4 and 5 above were in conformance with the rules of the Michigan Board of Professional Surveyors or by a Decree of a Court of Law; established, re-established, monumented, re-monumented, recovered, found as expressed below:

NOTE: Not more than 4 corners, all in the same town and range, may be recorded on this certificate.

A. Description of original monument and accessories and/or subsequent restoration:

B-2 1837 GLO Not Set  
1951 Williams & Works Set Iron at "X" 1/4 lines  
Fence Post SW 13.15'  
Fence Post NW 15.95'  
Fence W 6.0'

P.A. 345 1990 KENT COUNTY  
PEER APPROVED 10/26/95  
CHAIRMAN Harry Huber

B. Description of corner evidence found and/or method applied in restoring or reestablishing corner:


B-2 Did not find anything at corner. No fences or witnesses remain. Corner as established by "X" of 1/4 lines falls in a grassy field and found that the corners of fields and field divisions per property map fit the location of the corner more or less.

The intersection of 1/4 lines is accepted by me and is generally accepted by professional surveyors as the best available evidence of the position of the corner.

C. Description of monument for corner and accessories established to perpetuate locating the position of the corner:

B-2 Set Standard Kent County Monument at intersection of 1/4 lines.  
N 1/4 corner (Kent Co. Mon.) Sec. 6 North 2683.94'  
S 1/4 corner (Kent Co. Mon.) Sec. 6 South 2673.69'  
E 1/4 corner (Kent Co. Mon.) Sec. 6 East 2654.02'  
W 1/4 corner (Kent Co. Mon.) Sec. 6 West 2857.91'

No other objects for witnesses within 400'±

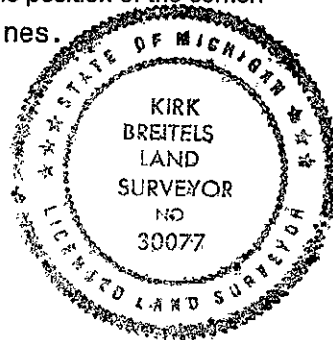

Signed by Kirk Breitels

Date 12/6/95

Surveyor's Michigan License No. 30077