

SURVEY &

REMONUMENTATION

\$7.00
\$2.00

SEP 18 1995

COMMISSION

KENT COUNTY REMONUMENTATION

LAND CORNER RECORDATION CERTIFICATE
Filing Requirement of Act 74, Mich. P.A. 1970

For corners in
KENT COUNTY
(County)

Located In: Corner Code #

- 1. Public Land Survey T 8N R 12W B-3
- 2. Property Controlling in Section S T R
- 3. Miscellaneous Property in Sec. S T R
- 4. Lot No. _____, Recorded Plat _____
- 5. Private Claims _____


STATE OF MICHIGAN
COUNTY OF KENT
RECEIVED FOR RECORD
95 JUN 29 AM 11:51
REG. OF DEEDS
Lucy St. Paul

8428

Register of Deeds Stamp & File Number

I, Kirk Breitels, in a field survey on Feb. 7, 1995, do hereby certify that under requirements of P.A. 74, Michigan P.A. of 1970, the corner points mentioned in lines 1 and 2 above were in conformance with regulations and rules therefore as required in the current manual of survey instructions of the United States Department of the Interior, Bureau of Land Management or by a decree of a Court of Law and/or that the corner points mentioned in lines 3, 4 and 5 above were in conformance with the rules of the Michigan Board of Land Surveyors or by a Decree of a Court of Law; established, re-established, monumented, re-monumented, recovered, found as expressed below:

NOTE: Not more than 4 corners, all in the same town and range, may be recorded on this certificate.

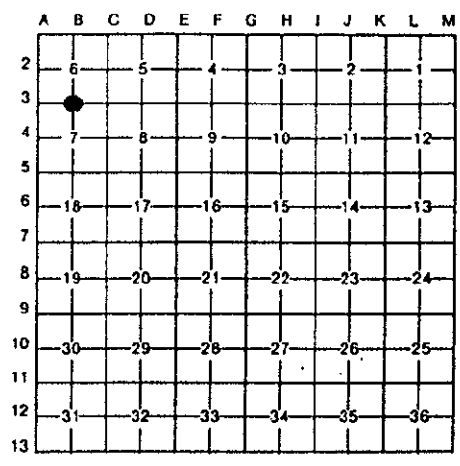

A. Description of original monument and accessories and/or subsequent restoration:

B-3	1838	GLO	Whitcomb	Set Post
	1961	Kent Co. Wit.		Conc. Mon.
	1980	LCRC #1366	Glaza	PK Nail
	1981	LCRC #2394	Bueche	Set Kent County Monument

The position of this corner was previously approved by the Kent County Remonumentation Peer Group, monumented by John C. Bueche on 11/9/81 and was recorded per LCRC #2394.

B. Description of corner evidence found and/or method applied in restoring or reestablishing corner:

B-3 Found standard Kent Co. Mon. (Harrison) per witnesses from above LCRC as set by John C. Bueche in place of the 60d nail he found. Said 60d nail checks with Kent Co. Wit. and LCRC #1366.

LCRC #2394

KC Remon. tag & nail S. side 38" Oak	N80°W	34.12'	
KC Remon. tag & nail E. side 36" Oak	N35°W	74.50'	
KC Remon. tag & nail E. side P. Pole	N15°E	125.00'	
KC Remon. tag & nail N. side 22" Hickory	S63°E	191.97'	
Nail S. side 6" Apple	N35°E	67.00'	
C/L blktp. East is South 2' m/1			
On C/L blktp. South			

P.A. 345 1990 KENT COUNTY

PEER APPROVED 6/22/95

CHAIRMAN *Harry H. Huber*

The selected location is accepted by me and is generally accepted by professional surveyors as the best available evidence of the position of the original corner.

C. Description of monument for corner and accessories established to perpetuate locating the position of the corner:

B-3 Standard Kent County Monument			
New KC Remon. tag & nail S. side 44" Oak	N80°W	34.15'	
New KC Remon. tag & nail E. side 40" Oak	N35°W	74.49'	
KC Remon. tag & nail E. side P. Pole	N15°E	125.06'	
New KC Remon. tag & nail N. side 26" Hickory	S63°E	192.03'	
Capped Iron - All Points	West	32.95'	
C/L blktp. East is South 2' m/1			
On C/L blktp. South			



Signed by *Kirk Breitels*

Date 6/22/95

Surveyor's Michigan License No. 30077