

\$7.00
\$2.00

JAN 24 1996

KENT COUNTY REMONUMENTATION

COMMISSION

LAND CORNER RECORDATION CERTIFICATE

Filing Requirement of Act 74, Mich. P.A. 1970

For corners in
KENT COUNTY
(County)

Located In:

Corner Code #

1. Public Land Survey	T	8N	R	12W	B-8
	T		R		
	T		R		
	T		R		
2. Property Controlling in Section	S	T	R		
	S	T	R		
3. Miscellaneous Property in Section	S	T	R		
	S	T	R		

REG. OF DEEDS

Lucy St. Paul

95 DEC 20 AM 8:37

STATE OF MICHIGAN
COUNTY OF KENT
RECEIVED FOR RECORD

8779

Register of Deeds Stamp & File Number

- 4. Lot No. _____, Recorded Plat _____
- 5. Private Claims _____

A	B	C	D	E	F	G	H	I	J	K	L
2	6	5	4	3	2	1					
3											
4	7	8	9	10	11	12					
5											
6	18	17	16	15	14	13					
7											
8	19	20	21	22	23	24					
9											
10	30	29	28	27	26	25					
11											
12	31	32	33	34	35	36					
13											

I, Kirk Breiteis, in a field survey on Sept. 7, 1995, do hereby certify that under requirements of P.A. 74, Michigan P.A. of 1970, the corner points mentioned in lines 1 and 2 above were in conformance with regulations and rules therefore as required in the current manual of survey instructions of the United States Department of the Interior, Bureau of Land Management or by a decree of a Court of Law and/or that the corner points mentioned in lines 3, 4 and 5 above were in conformance with the rules of the Michigan Board of Professional Surveyors or by a Decree of a Court of Law; established, re-established, monumented, re-monumented, recovered, found as expressed below:

NOTE: Not more than 4 corners, all in the same town and range, may be recorded on this certificate.

A. Description of original monument and accessories and/or subsequent restoration:

B-8 1837 GLO Not Set
 1976 LCRC #1044 McCloskey
 1/2" Iron from old witnesses
 17" Twin Ash SW 51.53'
 37" Ash WSW 58.94'
 "T" Iron E 33.00'
 Kent Co. Wit. 1/2" Iron
 same witnesses as LCRC #1044

1986 Survey Nederveld 1/2" Round Iron
 Guard Post N11°W 35.32'
 Guard Post S41°W 25.57'
 20" Basswood East 56.27'

1988 Survey Glaza Cor. per LCRC #1044
 P.A. 345 1990 KENT COUNTY
 PEER APPROVED 9/28/95
 CHAIRMAN *Harry J. Huber*

B. Description of corner evidence found and/or method applied in restoring or reestablishing corner:


B-8 Found PK Nail over top of bent 1/2" Solid Iron 5.8' W. & 2.6' S. of intersection of 1/4 lines. Measurements using PK Nail agree with those of the 1986 Nederveld and 1988 Glaza surveys.

Nail sd. 24" Basswood East 56.23'

The PK Nail over the bent 1/2" Round Iron is accepted by me and is generally accepted by professional surveyors as the best available evidence of the position of the corner.

C. Description of monument for corner and accessories established to perpetuate locating the position of the corner:

B-8 Set Standard Kent County Monument in place of PK Nail & bent Solid Iron.
 Set Nail & KC Remon. tag top guard rail post S40°W 25.26'
 Set Nail & KC Remon. tag top guard rail post S10°W 44.50'
 Set Nail & KC Remon. tag N. side 20" Ash S90°E 56.23'
 Set Nail & KC Remon. tag top guard rail post N10°W 52.73'
 Set Nail & KC Remon. tag top guard rail post N60°W 45.29'
 C/L N-S culv. is West 33' ±

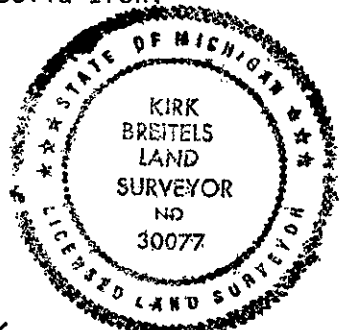

Signed by *Kirk Breiteis*

Date 12/6/95

Surveyor's Michigan License No. 30077