

JAN 24 1996

COMMISSION KENT COUNTY REMONUMENTATION

\$7.00  
\$2.00

LAND CORNER RECORDATION CERTIFICATE  
Filing Requirement of Act 74, Mich. P.A. 1970

For corners in  
KENT COUNTY  
(County)

Located In: Corner Code #

1. Public Land Survey	T	<u>8N</u>	R	<u>12W</u>	<u>B-10</u>
	T		R		
	T		R		
	T		R		
2. Property Controlling in Section	S		T		
	S		T		
3. Miscellaneous Property in Section	S		T		
	S		T		

STATE OF MICHIGAN  
COUNTY OF KENT  
RECEIVED FOR RECORD

95 DEC 20 AM 8:38

REG. OF DEEDS  
*Lucy Standa*  
8791

Register of Deeds Stamp & File Number

4. Lot No. \_\_\_\_\_, Recorded Plat \_\_\_\_\_  
5. Private Claims \_\_\_\_\_

I, Kirk Breiteis, in a field survey on Oct. 23, 1995, do hereby certify that under requirements of P.A. 74, Michigan P.A. of 1970, the corner points mentioned in lines 1 and 2 above were in conformance with regulations and rules therefore as required in the current manual of survey instructions of the United States Department of the Interior, Bureau of Land Management or by a decree of a Court of Law and/or that the corner points mentioned in lines 3, 4 and 5 above were in conformance with the rules of the Michigan Board of Professional Surveyors or by a Decree of a Court of Law; established, re-established, monumented, re-monumented, recovered, found as expressed below:

A	B	C	D	E	F	G	H	I	J	K	L	M
2	6	5	4	3	2	1						
3												
4	7	8	9	10	11	12						
5												
6	18	17	16	15	14	13						
7												
8	19	20	21	22	23	24						
9												
10	30	29	28	27	26	25						
11												
12	31	32	33	34	35	36						
13												

NOTE: Not more than 4 corners, all in the same town and range, may be recorded on this certificate.

A. Description of original monument and accessories and/or subsequent restoration:

- B-10 1837 GLO Not Set
- 1962 Williams & Works Set Iron at "X" 1/4 lines
- 1975 Surveys' Exxel Eng. "X" 1/4 lines-no point set

P.A. 345 1990 KENT COUNTY  
PEER APPROVED 10/26/95  
CHAIRMAN *Harry Huber*


B. Description of corner evidence found and/or method applied in restoring or reestablishing corner:

B-10 Found "T" Iron 0.8' N. & 0.5' W. of intersection 1/4 lines. Measurements and angles from 1962 Williams & Works survey fits the computed intersection 1/4 lines better than it does to the "T" Iron. Surveys by Exxel Eng. and others in Sec. 30 fit intersection 1/4 lines better than they do the "T" Iron (No public information on the "T" Iron being the Center of Section - i.e. LCRC's, Kent Co. Wit., or recorded surveys).

The intersection of 1/4 lines is accepted by me and is generally accepted by professional surveyors as the best available evidence of the position of the corner.

C. Description of monument for corner and accessories established to perpetuate locating the position of the corner:

- B-10 Set Standard Kent County Monument at the intersection of 1/4 lines
- Set Nail & KC Remon. tag N. side 12" Ash N75°E 32.05'
- Set Nail & KC Remon. tag E. side 36" Oak N10°E 25.32'
- Set Nail & KC Remon. tag W. side 18" Cherry N25°W 8.77'
- Set Nail & KC Remon. tag SW side 15" Maple N45°W 20.35'
- "T" Iron N35°W 0.94'

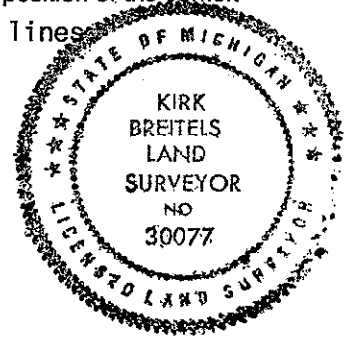

Signed by *Kirk Breiteis*  
30077

Date 12/6/95

Surveyor's Michigan License No. \_\_\_\_\_