

SEP 18 1995

\$7.00
\$2.00

COMMISSION

KENT COUNTY REMONUMENTATION

STATE OF MICHIGAN
COUNTY OF KENT
RECEIVED FOR RECORD

95 JUN 29 AM 11:51

LAND CORNER RECORDATION CERTIFICATE
Filing Requirement of Act 74, Mich. P.A. 1970

Lucy Bond
REG. OF DEEDS


For corners in
KENT COUNTY

(County)	Located In:	Corner Code -#
1. Public Land Survey	T <u>8N</u> R <u>12W</u>	B-11
	T _____ R _____	_____
	T _____ R _____	_____
	T _____ R _____	_____
2. Property Controlling in Section	S _____ T _____ R _____	_____
	S _____ T _____ R _____	_____
3. Miscellaneous Property in Sec.	S _____ T _____ R _____	_____
	S _____ T _____ R _____	_____
4. Lot No. _____, Recorded Plat _____		
5. Private Claims _____		

8431

Register of Deeds Stamp & File Number

I, Kirk Breitels, in a field survey on Feb. 7, 1995, do hereby certify that under requirements of P.A. 74, Michigan P.A. of 1970, the corner points mentioned in lines 1 and 2 above were in conformance with regulations and rules therefore as required in the current manual of survey instructions of the United States Department of the Interior, Bureau of Land Management or by a decree of a Court of Law and/or that the corner points mentioned in lines 3, 4 and 5 above were in conformance with the rules of the Michigan Board of Land Surveyors or by a Decree of a Court of Law; established, re-established, monumented, re-monumented, recovered, found as expressed below:

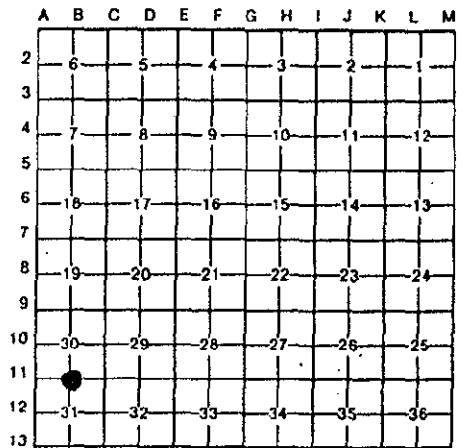

NOTE: Not more than 4 corners, all in the same town and range, may be recorded on this certificate.

A. Description of original monument and accessories and/or subsequent restoration:

B-11	1838	GLO	Whitcomb	Set Post
	1885	Williams & Works		Stone
	1935	Kent Co. Wit.		1/2" Solid Iron
	1950-62	Williams & Works		Iron
	1986	LCRC #4409	Bueche	Set Kent County Monument

The position of this corner was previously approved by the Kent County Remonumentation Peer Group, monumented by John C. Bueche on 4/14/86 and was recorded per LCRC #4409.

B. Description of corner evidence found and/or method applied in restoring or reestablishing corner:

B-11 Found standard Kent Co. Mon. (Harrison) per witnesses from above LCRC as set by John C. Bueche in place of the 1" x 18" & buggy axle he found over a stone. All check with Kent Co. Wit. and Williams & Works information

LCRC #4409

KC Remon. tag & nail S. side 12" Maple	N55°W	68.00'
SE cor. conc. fnd. to hse. #4405	N10°W	72.83'
SW cor. hse. #4405	N20°W	78.25'
KC Remon. tag & nail E. side 14" Maple	N05°E	25.10'
KC Remon. tag & nail SE side 26" Maple	N60°E	64.09'
KC Remon. tag & nail E. side P. Pole	South	80.72'

P.A. 345 1990 KENT COUNTY
PEER APPROVED 6/22/95

CHAIRMAN *Harvey Huber*

The selected location is accepted by me and is generally accepted by professional surveyors as the best available evidence of the position of the original corner.

C. Description of monument for corner and accessories established to perpetuate locating the position of the corner:

B-11 Standard Kent County Monument

New KC Remon. tag & nail S. side 16" Maple	N55°W	68.07'
SE cor. conc. fnd. to hse. #4405	N10°W	72.83'
SW cor. hse. #4405	N20°W	78.25'
New KC Remon. tag & nail E. side 18" Maple	N05°E	25.09'
New KC Remon. tag & nail SE side 30" Maple	N60°E	64.13'
KC Remon. tag & nail E. side P. Pole	South	80.72'



Signed by

Kirk Breitels

Date

6/22/95

Surveyor's Michigan License No.

30077