

SEP 18 1995

KENT COUNTY REMONUMENTATION

COMMISSION

LAND CORNER RECORDATION CERTIFICATE

Filing Requirement of Act 74, Mich. P.A. 1970

For corners in KENT COUNTY (County)

Located In:

Corner Code #

1. Public Land Survey	T	8N	R	12W	C-2
	T		R		
	T		R		
	T		R		
2. Property Controlling in Section	S		T	R	
	S		T	R	
3. Miscellaneous Property in Section	S		T	R	
	S		T	R	

REG. OF DEEDS

*Lucy Bond*


95 AUG 29 AM 10:39

STATE OF MICHIGAN COUNTY OF KENT RECEIVED FOR RECORD

8686

Register of Deeds Stamp & File Number

4. Lot No. \_\_\_\_\_, Recorded Plat \_\_\_\_\_  
5. Private Claims \_\_\_\_\_

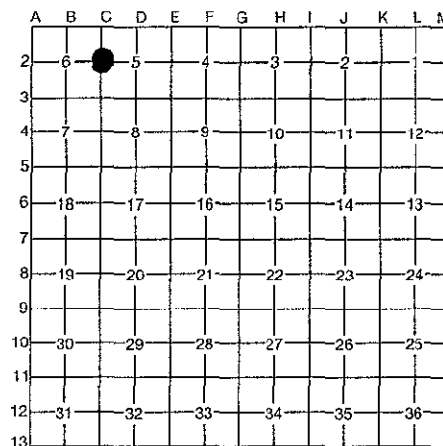

I, Kirk Breitels, in a field survey on Aug. 1, 1995

do hereby certify that under requirements of P.A. 74, Michigan P.A. of 1970, the corner points mentioned in lines 1 and 2 above were in conformance with regulations and rules therefore as required in the current manual of survey instructions of the United States Department of the Interior, Bureau of Land Management or by a decree of a Court of Law and/or that the corner points mentioned in lines 3, 4 and 5 above were in conformance with the rules of the Michigan Board of Professional Surveyors or by a Decree of a Court of Law; established, re-established, monumented, re-monumented, recovered, found as expressed below:

NOTE: Not more than 4 corners, all in the same town and range, may be recorded on this certificate.

A. Description of original monument and accessories and/or subsequent restoration:

C-2	1838	GLO	Whitcomb	Set Post
	1899	Williams & Works		Pig Iron, Brick, Plow Point
	1939	Kent Co. Wit.		Conc. Monument
	1951	Williams & Works		Iron
	1985	LCRC #4324	Bueche	Set Kent County Monument in mon. box

The position of this corner was previously approved by the Kent County Remonumentation Peer Group, monumented by John C. Bueche on 11/29/85 and was recorded per LCRC #4324.

B. Description of corner evidence found and/or method applied in restoring or reestablishing corner:

C-2 Found standard Kent Co. Mon. (Harrison) per witnesses from above LCRC as set by John C. Bueche in place of the Conc. Mon. he found inside a mon. box. Said Conc. Mon. checks with Kent Co. Wit. and Williams & Works information.

LCRC #4324

Nail & KC Remon. tag NW side P. Pole	S35°E	123.50'
Nail & KC Remon. tag SW side P. Pole	N65°E	153.02'
Nail in N. side 12" Apple	S60°E	78.56'
Nail in E. side 12" Sycamore	N20°W	171.93'

P.A. 345 1990 KENT COUNTY

PEER APPROVED 8/24/95

CHAIRMAN *Harvey Huber*

The selected location is accepted by me and is generally accepted by professional surveyors as the best available evidence of the position of the original corner.

C. Description of monument for corner and accessories established to perpetuate locating the position of the corner:

C-2 Standard Kent County Monument

Nail & KC Remon. tag SW side P. Pole	S35°E	153.02'
Nail & KC Remon. tag NW side P. Pole	N65°E	123.40'
Set Nail & KC Remon. tag N. side 15" Apple	S60°E	78.51'
Set Nail & KC Remon. tag E. side 24" Sycamore	N20°W	171.93'
C/L Asph. Rd. N-S is East 1' ±		

Measurements were reversed in "B"

Signed by *Kirk Breitels*

Date 8/24/95

Surveyor's Michigan License No. 30077

