

SEP 18 1995

KENT COUNTY REMONUMENTATION

COMMISSION

LAND CORNER RECORDATION CERTIFICATE

Filing Requirement of Act 74, Mich. P.A. 1970


For corners in KENT COUNTY (County)

Located In: Corner Code #

Table with 3 columns: Description, Located In (T, S, R), and Corner Code #. Includes rows for Public Land Survey, Property Controlling in Section, and Miscellaneous Property in Section.

Register of Deeds Stamp & File Number. Includes vertical stamp: STATE OF MICHIGAN COUNTY OF KENT RECEIVED FOR RECORD 95 AUG 29 AM 10:38 and handwritten file number 8687.

4. Lot No. , Recorded Plat
5. Private Claims

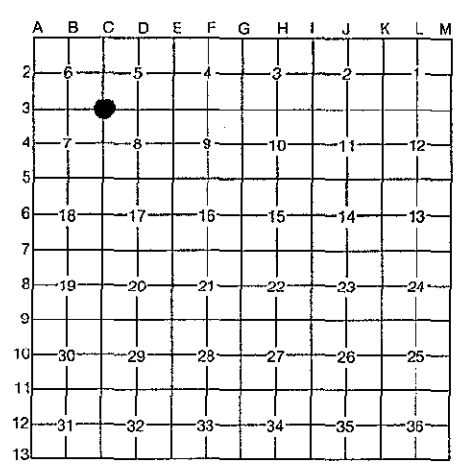

Kirk Breitels, in a field survey on Aug. 1, 1995

do hereby certify that under requirements of P.A. 74, Michigan P.A. of 1970, the corner points mentioned in lines 1 and 2 above were in conformance with regulations and rules therefore as required in the current manual of survey instructions of the United States Department of the Interior, Bureau of Land Management or by a decree of a Court of Law and/or that the corner points mentioned in lines 3, 4 and 5 above were in conformance with the rules of the Michigan Board of Professional Surveyors or by a Decree of a Court of Law; established, re-established, monumented, re-monumented, recovered, found as expressed below:

NOTE: Not more than 4 corners, all in the same town and range, may be recorded on this certificate.

A. Description of original monument and accessories and/or subsequent restoration:

Table listing monument details: C-3, 1838 GLO Whitcomb Set Post, 1896 Williams & Works Brick, Stone, Stake, 1939 Kent Co. Wit. Conc. Monument, 1967 Williams & Works Mon. Box, 1985 LCRC #4325 Bueche Set Kent County Monument in mon. box

The position of this corner was previously approved by the Kent County Remonumentation Peer Group, monumented by John C. Bueche on 11/29/85 and was recorded per LCRC #4325.

B. Description of corner evidence found and/or method applied in restoring or reestablishing corner:

C-3 Found standard Kent Co. Mon. (Harrison) per witnesses from above LCRC as set by John C. Bueche in place of the Conc. Mon. in a mon. box he found. Said Conc. Mon. checks with Kent Co. Wit. and Williams & Works information.

LCRC #4325

- "X" cut on conc. curb N35°W 48.40'
"X" cut on conc. curb N30°E 38.37'
"X" cut on conc. curb S55°W 42.41'
"X" cut on conc. curb S20°E 42.30'
PK Nail in N. side P. Pole S60°E 54.43'

P.A. 345 1990 KENT COUNTY PEER APPROVED 8/24/95 CHAIRMAN Harry Hubert

C/L blacktop N-S is West 4' ±; On C/L blacktop E-W

The selected location is accepted by me and is generally accepted by professional surveyors as the best available evidence of the position of the original corner.

C. Description of monument for corner and accessories established to perpetuate locating the position of the corner:

C-3 Standard Kent County Monument

- "X" cut on conc. curb N35°W 48.37'
"X" cut on conc. curb N30°E 38.37'
"X" cut on conc. curb S55°W 42.38'
"X" cut on conc. curb S20°E 42.34'
Set Nail & KC Remon. tag N. side P. Pole S60°E 54.43'
C/L blacktop N-S is West 4' ±; On C/L blacktop E-W



Signed by [Signature]

Date 8/24/95

Surveyor's Michigan License No. 30077