

SEP 13 1995

KENT COUNTY REMONUMENTATION

COMMISSION

LAND CORNER RECORDATION CERTIFICATE

Filing Requirement of Act 74, Mich. P.A. 1970

For corners in KENT COUNTY (County)

Located In:


Corner Code #

1. Public Land Survey	T	8N	R	12W	C-4
	T		R		
	T		R		
	T		R		
2. Property Controlling in Section	S		T	R	
	S		T	R	
3. Miscellaneous	S		T	R	
Property in Section	S		T	R	

STATE OF MICHIGAN
 SURVEYOR OF KENT COUNTY
 RECEIVED FOR RECORD
 95 AUG 29 AM 10:38
 95 AUG 29 AM 10:38
 REG. OF DEEDS
 REG. OF DEEDS
 REG. OF DEEDS

Register of Deeds Stamp & File Number

4. Lot No. _____, Recorded Plat _____
 5. Private Claims _____

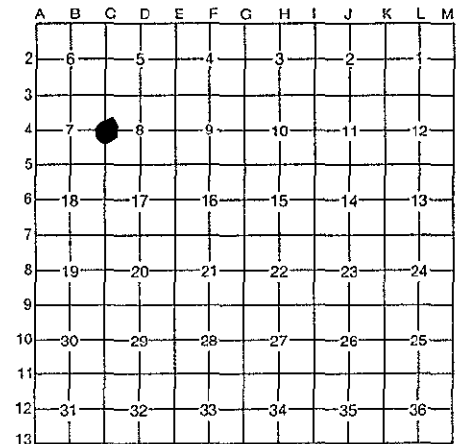

Kirk Breitels

Aug. 1, 1995

I, Kirk Breitels, in a field survey on Aug. 1, 1995, do hereby certify that under requirements of P.A. 74, Michigan P.A. of 1970, the corner points mentioned in lines 1 and 2 above were in conformance with regulations and rules therefore as required in the current manual of survey instructions of the United States Department of the Interior, Bureau of Land Management or by a decree of a Court of Law and/or that the corner points mentioned in lines 3, 4 and 5 above were in conformance with the rules of the Michigan Board of Professional Surveyors or by a Decree of a Court of Law; established, re-established, monumented, re-monumented, recovered, found as expressed below:

NOTE: Not more than 4 corners, all in the same town and range, may be recorded on this certificate.

A. Description of original monument and accessories and/or subsequent restoration:

C-4	1838	GLO	Whitcomb	Set Post
	1939	Kent Co. Wit.		Conc. Monument
	1967	Williams & Works		Mon. Box
	1986	LCRC #4410	Bueche	Set Kent County Monument in mon. box

The position of this corner was previously approved by the Kent County Remonumentation Peer Group, monumented by John C. Bueche on 4/14/86 and was recorded per LCRC #4410

B. Description of corner evidence found and/or method applied in restoring or reestablishing corner:

C-4 Found standard Kent Co. Mon. (Harrison) per witnesses from above LCRC as set by John C. Bueche in place of the Conc. Mon. he found inside a mon. box. Said Conc. Mon. checks with Kent Co. Wit. and Williams & Works information.

LCRC #4410

Nail & KC Remon. tag W. side 12" Elm	S25°W	109.30'
Nail & KC Remon. tag S. side 28" Maple	East	78.68'
Nail & KC Remon. tag S. side 6" dbl. Elm	N60°E	53.94'
Nail & KC Remon. tag N. side P. Pole	S20°E	113.25'
Face of 6" Cherry	N80°W	64.60'

P.A. 345 1990 KENT COUNTY

PEER APPROVED 8/24/95
 CHAIRMAN *John C. Bueche*

C/L blacktop N-S is East 2.5' ±; C/L 2 track East is North 13' ±

The selected location is accepted by me and is generally accepted by professional surveyors as the best available evidence of the position of the original corner.

C. Description of monument for corner and accessories established to perpetuate locating the position of the corner:

C-4 Standard Kent County Monument

New Nail & KC Remon. tag W. side 24" Elm	S25°W	109.32'
New Nail & KC Remon. tag S. side 36" Maple	East	78.68'
Nail & KC Remon. tag NE side P. Pole	S20°E	113.06'
Set Nail & KC Remon. tag SE side P. Pole	S60°W	111.83'
Set Nail & KC Remon. tag S. side 12" Elm	N65°E	69.72'

C/L blacktop N-S is East 2.5' ±; C/L 2 track East is North 13' ±



Signed by *Kirk Breitels*

Date 8/24/95

Surveyor's Michigan License No. 30077