

SEP 18 1995

KENT COUNTY REMONUMENTATION

COMMISSION

LAND CORNER RECORDATION CERTIFICATE

Filing Requirement of Act 74, Mich. P.A. 1970

For corners in KENT COUNTY (County)


Located In:

Corner Code #

1. Public Land Survey	T	8N	R	12W	C-7
	T		R		
	T		R		
	T		R		
2. Property Controlling in Section	S		T	R	
	S		T	R	
3. Miscellaneous Property in Section	S		T	R	
	S		T	R	

STATE OF MICHIGAN
 COUNTY OF KENT
 RECEIVED FOR RECORD
 95 AUG 29 AM 10:39
 REG. OF DEEDS
 8
 Register of Deeds Stamp & File Number

4. Lot No. _____, Recorded Plat _____
 5. Private Claims _____

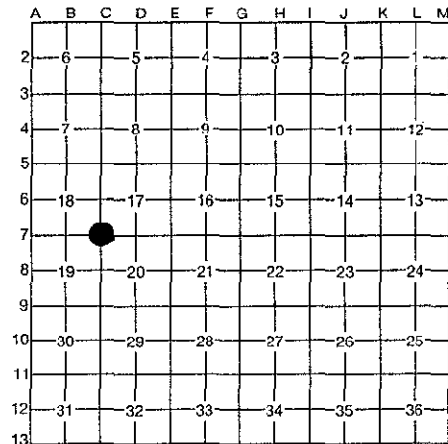

I, Kirk Breitels, in a field survey on Aug. 1, 1995, do hereby certify that under requirements of P.A. 74, Michigan P.A. of 1970, the corner points mentioned in lines 1 and 2 above were in conformance with regulations and rules therefore as required in the current manual of survey instructions of the United States Department of the Interior, Bureau of Land Management or by a decree of a Court of Law and/or that the corner points mentioned in lines 3, 4 and 5 above were in conformance with the rules of the Michigan Board of Professional Surveyors or by a Decree of a Court of Law; established, re-established, monumented, re-monumented, recovered, found as expressed below:

NOTE: Not more than 4 corners, all in the same town and range, may be recorded on this certificate.

A. Description of original monument and accessories and/or subsequent restoration:

C-7	1838	GLO	Whitcomb	Set Post
		Kent Co. Wit.		Conc. Mon.
	1977	LCRC #1227	Byl	Iron Pipe in Mon. Box
	1981	LCRC #2396	Bueche	Set Kent County Monument in mon. box

The position of this corner was previously approved by the Kent County Remonumentation Peer Group, monumented by John C. Bueche on 11/10/81 and was recorded per LCRC #2396.

B. Description of corner evidence found and/or method applied in restoring or reestablishing corner:

C-7 Found standard Kent Co. Mon. (Harrison) per witnesses from above LCRC as set by John C. Bueche in place of the 1" Iron Pipe (Conc. Mon.) he found inside a mon. box. Said Iron (Conc. Mon.) checks with Kent Co. Wit. and LCRC #1227.

LCRC #2396

"X" cut in conc. curb return	N60°W	40.46'
"X" cut in conc. curb return	N50°E	51.83'
"X" cut in conc. curb return	S45°E	53.48'
"X" cut in NW cor. conc. headwall	S15°W	73.16'
Nail & KC Remon. tag in top of fence post	N45°E	91.11'
C/L blktp. N-S is East 1' m/l; On C/L blktp. E-W		

P.A. 345 1990 KENT COUNTY
 PEER APPROVED: 8/24/95
 CHAIRMAN: *Harry Huber*

The selected location is accepted by me and is generally accepted by professional surveyors as the best available evidence of the position of the original corner.

C. Description of monument for corner and accessories established to perpetuate locating the position of the corner:

C-7 Standard Kent County Monument

"X" cut in conc. curb return	N50°E	51.83'
"X" cut in conc. curb return	S45°E	53.50'
"X" cut in NW cor. conc. headwall	S15°W	73.16'
C/L MBT Manhole	N45°E	68.10'
Set Nail & KC Remon. tag NE side P. Pole	N35°W	74.35'
C/L blktp. N-S is East 1' m/l; On C/L blktp. E-W		



Signed by *Kirk Breitels*

Date 8/24/95

Surveyor's Michigan License No. 30077