

SEP 18 1995

KENT COUNTY REMONUMENTATION

COMMISSIONER

LAND CORNER RECORDATION CERTIFICATE

Filing Requirement of Act 74, Mich. P.A. 1970

For corners in KENT COUNTY (County)

Located In:

Corner Code #


1. Public Land Survey	T	8N	R	12W	C-9
	T		R		
	T		R		
	T		R		
2. Property Controlling in Section	S		T	R	
	S		T	R	
3. Miscellaneous Property in Section	S		T	R	
	S		T	R	

STATE OF MICHIGAN
 COUNTY OF KENT
 RECEIVED FOR RECORD
 95 AUG 29 AM 10:39
 REG. OF DEEDS
Luigi Standa
 8693

Register of Deeds Stamp & File Number

4. Lot No. _____, Recorded Plat _____
 5. Private Claims _____

I, Kirk Breitels, in a field survey on Aug 1, 19 95, do hereby certify that under requirements of P.A. 74, Michigan P.A. of 1970, the corner points mentioned in lines 1 and 2 above were in conformance with regulations and rules therefore as required in the current manual of survey instructions of the United States Department of the Interior, Bureau of Land Management or by a decree of a Court of Law and/or that the corner points mentioned in lines 3, 4 and 5 above were in conformance with the rules of the Michigan Board of Professional Surveyors or by a Decree of a Court of Law; established, re-established, monumented, re-monumented, recovered, found as expressed below:

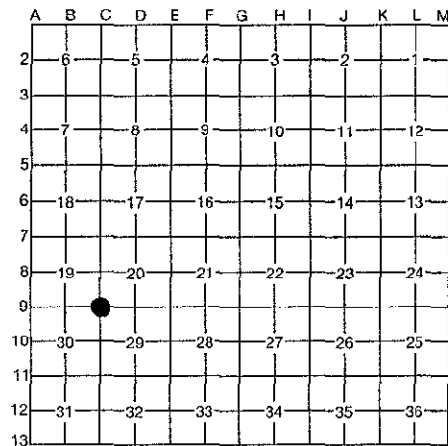

NOTE: Not more than 4 corners, all in the same town and range, may be recorded on this certificate.

A. Description of original monument and accessories and/or subsequent restoration:

C-9	1838	GLO	Whitcomb	Set Post
		Kent Co. Wit.		Mon. Box
	1972	LCRC #254	Spicer	3/4" Iron in Mon. Box
	1972	LCRC #454	VanKooten	1" Iron in Mon. Box
	1981	LCRC #2616	Nederveld	Set Kent County Monument in mon. box

The position of this corner was previously approved by the Kent County Remonumentation Peer Group, monumented by Gordon D. Nederveld on 9/15/81 and was recorded per LCRC #2616

B. Description of corner evidence found and/or method applied in restoring or reestablishing corner:

C-9 Found standard Kent Co. Mon. (Harrison) per witnesses from above LCRC as set by Gordon D. Nederveld in place of the 3/4" Iron he found inside a Mon. Box. Said Iron checks with Kent Co. Wit. and LCRC's #254 & #454.

LCRC #2616

Nail & KC Remon. tag NE side T. Pole	N46°W	52.72'
Nail & KC Remon. tag NW side Guy Pole	S28°W	92.00'
Nail & KC Remon. tag SW side P. Pole	S40°E	109.02'
Nail & KC Remon. tag N. side 30" Maple	S75°E	144.82'

P.A. 345 1990 KENT COUNTY
 PEER APPROVED 8/24/95
 CHAIRMAN *Stan Huber*

The selected location is accepted by me and is generally accepted by professional surveyors as the best available evidence of the position of the original corner.

C. Description of monument for corner and accessories established to perpetuate locating the position of the corner:

C-9 Standard Kent County Monument in mon. box		
Nail & KC Remon. tag SW side P. Pole	S40°E	109.02'
Set Nail & KC Remon. tag NW side P. Pole	N65°E	76.29'
Cut "X" top of curb	N40°W	51.55'
Cut "X" top of curb	S40°W	51.24'
On C/L bit. roads N-S & E-W		



Signed by *Kirk Breitels*

Date 8/24/95

Surveyor's Michigan License No. 30077