

\$7.00  
\$2.00

SEP 18 1995

KENT COUNTY REMONUMENTATION

COMMISSION

LAND CORNER RECORDATION CERTIFICATE  
Filing Requirement of Act 74, Mich. P.A. 1970

For corners in  
KENT COUNTY  
(County)

Located In: \_\_\_\_\_ Corner Code # \_\_\_\_\_

1. Public Land Survey	T	<u>8N</u>	R	<u>12W</u>	<u>D-1</u>
	T	_____	R	_____	_____
	T	_____	R	_____	_____
	T	_____	R	_____	_____
2. Property Controlling in Section	S	_____	T	_____	R
	S	_____	T	_____	R
3. Miscellaneous Property in Section	S	_____	T	_____	R
	S	_____	T	_____	R

STATE OF MICHIGAN  
COUNTY OF KENT  
RECEIVED FOR RECORD

95 JUN 29 AM 11:52


REG. OF DEEDS  
*Luis Standa*

**8437**

Register of Deeds Stamp & File Number

4. Lot No. \_\_\_\_\_, Recorded Plat \_\_\_\_\_

5. Private Claims \_\_\_\_\_

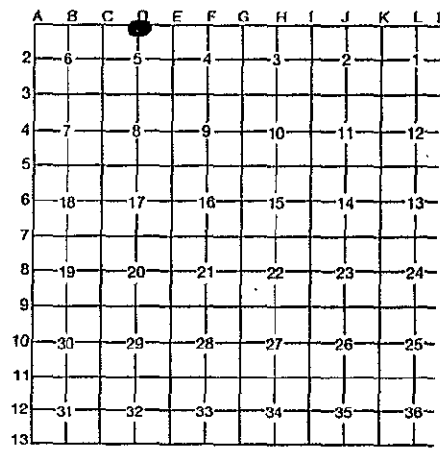

I, Kirk Breitels, in a field survey on Feb. 7, 1995, do hereby certify that under requirements of P.A. 74, Michigan P.A. of 1970, the corner points mentioned in lines 1 and 2 above were in conformance with regulations and rules therefore as required in the current manual of survey instructions of the United States Department of the Interior, Bureau of Land Management or by a decree of a Court of Law and/or that the corner points mentioned in lines 3, 4 and 5 above were in conformance with the rules of the Michigan Board of Professional Surveyors or by a Decree of a Court of Law; established, re-established, monumented, re-monumented, recovered, found as expressed below:

NOTE: Not more than 4 corners, all in the same town and range, may be recorded on this certificate.

A. Description of original monument and accessories and/or subsequent restoration:

D-1	1838	GLO	Not Set
	1899	Williams & Works	Plow Point
	1966	Kent Co. Wit.	Conc. Mon. (Mon. Box)
	1984	LCRC #4084	Kolehouse Set Kent County Monument in mon. box
	1991	LCRC #6112	Byl Kent County Monument in mon. box

The position of this corner was previously approved by the Kent County Remonumentation Peer Group, monumented by Randy J. Kolehouse on 12/8/84 and was recorded per LCRC #4084

B. Description of corner evidence found and/or method applied in restoring or reestablishing corner:  
D-1 Found standard Kent Co. Mon. (Harrison) per witnesses from above LCRC as set by Randy J. Kolehouse on twp. line in place of the 1" Iron he found over a 1/2" Iron inside a mon. box. Both Irons check with Kent Co. Wit. and Williams & Works information.  
LCRC #6112 (LCRC #4084 ~ same witnesses)

Nail & KC Remon. tag W. side 12" Apple	S15°E	76.85'
Nail & KC Remon. tag W. side P. Pole	N30°E	101.47'
C/L 3" Apple	N05°E	43.25'
C/L 3" Apple	N45°W	55.9'
C/L 3" Apple	N45°E	62.7'
KC Mon., S 1/4 cor. Sec. 32, T9N, R12W	West	265.20'

P.A. 345 1990 KENT COUNTY  
PEER APPROVED 6/22/95  
CHAIRMAN Larry Huber

The selected location is accepted by me and is generally accepted by professional surveyors as the best available evidence of the position of the corner.

C. Description of monument for corner and accessories established to perpetuate locating the position of the corner:

D-1 Standard Kent County Monument in mon. box		
Nail & KC Remon. tag W. side P. Pole	N30°E	101.47'
C/L 4" Apple	N05°E	43.25'
C/L 4" Apple	N45°W	55.9'
C/L 4" Apple	N45°E	62.7'
KC Mon., S 1/4 cor. Sec. 32, T9N, R12W	West	265.31'



Signed by Kirk Breitels Date 6/22/95  
Surveyor's Michigan License No. 30077