

REMONUMENTATION

JAN 24 1996

KENT COUNTY REMONUMENTATION

COMMISSION LAND CORNER RECORDATION CERTIFICATE  
Filing Requirement of Act 74, Mich. P.A. 1970

\$7.00  
\$2.00

For corners in  
KENT COUNTY  
(County)

Located In: Corner Code #

1. Public Land Survey	T	8N	R	12W	D-2
	T		R		
	T		R		
	T		R		
2. Property Controlling in Section	S		T	R	
	S		T	R	
3. Miscellaneous Property in Section	S		T	R	
	S		T	R	

STATE OF MICHIGAN  
COUNTY OF KENT  
RECEIVED FOR RECORD

95 DEC 20 AM 8:36

REG. OF DEEDS  
*Luigi Standa*  
8767

Register of Deeds Stamp & File Number

- 4. Lot No. \_\_\_\_\_, Recorded Plat \_\_\_\_\_
- 5. Private Claims \_\_\_\_\_

A	B	C	D	E	F	G	H	I	J	K	L	M
2	6		5	4		3		2		1		
3												
4	7	8		9		10		11		12		
5												
6	18	17		16		15		14		13		
7												
8	19	20		21		22		23		24		
9												
10	30	29		28		27		26		25		
11												
12	31	32		33		34		35		36		

I, Kirk Breitels, in a field survey on Oct. 23, 1995

do hereby certify that under requirements of P.A. 74, Michigan P.A. of 1970, the corner points mentioned in lines 1 and 2 above were in conformance with regulations and rules therefore as required in the current manual of survey instructions of the United States Department of the Interior, Bureau of Land Management or by a decree of a Court of Law and/or that the corner points mentioned in lines 3, 4 and 5 above were in conformance with the rules of the Michigan Board of Professional Surveyors or by a Decree of a Court of Law; established, re-established, monumented, re-monumented, recovered, found as expressed below:

NOTE: Not more than 4 corners, all in the same town and range, may be recorded on this certificate.

A. Description of original monument and accessories and/or subsequent restoration:

D-2 1837 GLO Not Set  
1900 Williams & Works "Sec. survey sketch indicates point set for Center-cannot tell what it is"

No other information available or submitted for this corner

P.A. 345 1990 KENT COUNTY  
PEER APPROVED 10/26/95  
CHAIRMAN *Harry Huber*


B. Description of corner evidence found and/or method applied in restoring or reestablishing corner:

D-2 Found nothing at corner. Established "X" of 1/4 lines and found remains of fence to East to be 2'± South and remains of fence North & South to be 2'± West.  
Measure to N 1/4 cor.: 2782.00' - 2782.5' Williams & Works 1900  
Measure to S 1/4 cor.: 2646.63' - 2646.5' Williams & Works 1900

The intersection of 1/4 lines is accepted by me and is generally accepted by professional surveyors as the best available evidence of the position of the corner.

C. Description of monument for corner and accessories established to perpetuate locating the position of the corner:

D-2 Set Standard Kent County Monument at intersection of 1/4 lines.  
Set Nail & KC Remon. tag W. side cluster 15" Elm S10°E 3.81'  
Set Nail & KC Remon. tag N. side cluster 8" Elm S90°E 19.17'  
Set Nail & KC Remon. tag E. side 6" Beech N20°E 15.15'  
Set Nail & KC Remon. tag SE side 6" Beech N50°E 20.00'

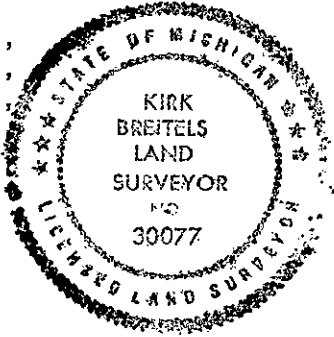

Signed by *Kirk Breitels* Date 12/6/95  
Surveyor's Michigan License No. 30077