SURVEY & REMONUMENTATION

JAN 2 4 1996

$7.00
$2.00

COMMISSION

KENT COUNTY REMONUMENTATION

**LAND CORNER RECORDATION CERTIFICATE**
**Filing Requirement of Act 74, Mich. P.A. 1970**

For corners in KENT COUNTY (County)

| | Located In: | Corner Code # |
|---|---|---|
| 1. Public Land Survey | T 8N R 12W | D-6 |
| | T ___ R ___ | |
| | T ___ R ___ | |
| | T ___ R ___ | |
| 2. Property Controlling | S ___ T ___ R ___ | |
| in Section | S ___ T ___ R ___ | |
| 3. Miscellaneous | S ___ T ___ R ___ | |
| Property in Section | S ___ T ___ R ___ | |

STATE OF MICHIGAN
COUNTY OF KENT
RECEIVED FOR RECORD
95 DEC 20 AM 8:37
REG. OF DEEDS
8777

**Register of Deeds Stamp & File Number**

4. Lot No. _____, Recorded Plat _____
5. Private Claims _____

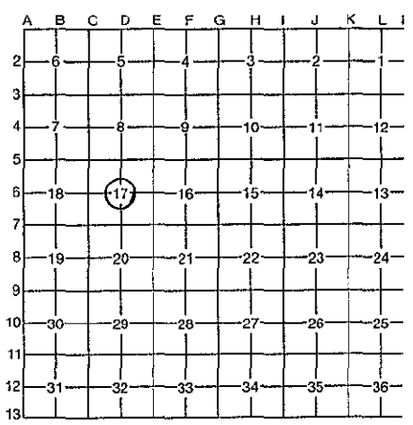


I, Kirk Breitels, in a field survey on Sept. 8, 19 95, do hereby certify that under requirements of P.A. 74, Michigan P.A. of 1970, the corner points mentioned in lines 1 and 2 above were in conformance with regulations and rules therefore as required in the current manual of survey instructions of the United States Department of the Interior, Bureau of Land Management or by a decree of a Court of Law and/or that the corner points mentioned in lines 3, 4 and 5 above were in conformance with the rules of the Michigan Board of Professional Surveyors or by a Decree of a Court of Law; established, re-established, monumented, re-monumented, recovered, found as expressed below:

**NOTE: Not more than 4 corners, *all in the same town and range, may be recorded* on this certificate.**

A. Description of original monument and accessories and/or subsequent restoration:

D-6 1837 GLO Not Set
1977 Survey Byl Comp. "X" 1/4 lines.
1981 Survey MVK Iron
10" Apple NE 62.15' 10" Apple SE 81.90'

P.A. 345 1990 KENT COUNTY
PEER APPROVED 9/28/95
CHAIRMAN Harry Shubel

B. Description of corner evidence found and/or method applied in restoring or reestablishing corner:

D-6 Found Capped Rerod (MVK) 0.4' W. & 0.6' N. of intersection of 1/4 lines. Per MVK survey information the Center is on the true N-S 1/4 line and dimensions given compare favorably with those to the computed intersection of 1/4 lines rather than those measured to the Capped Rerod found.. 1977 Byl survey information compares favorably with the intersection of 1/4 lines as computed.

The Intersection of 1/4 lines is accepted by me and is generally accepted by professional surveyors as the best available evidence of the position of the corner.

C. Description of monument for corner and accessories established to perpetuate locating the position of the corner:

D-6 Set Standard Kent County Monument at intersection of 1/4 lines.

| | | |
|---|---|---|
| Set Nail & KC Remon. tag N. side 12" Poplar | N85°E | 13.51' |
| Set Nail & KC Remon. tag NE side 6" Poplar | S45°E | 11.43' |
| Set Nail & KC Remon. tag SE side 12" Poplar | N45°E | 19.94' |
| C/L 3" Apple (1st row West) | N65°W | 17.4' |
| C/L 3" Apple (2nd row West) | S60°W | 41.9' |
| Capped Rerod (MVK) | N35°W | 0.75' |

STATE OF MICHIGAN
KIRK BREITELS
LAND SURVEYOR
NO 30077
LICENSED LAND SURVEYOR

Signed by Kirk Breitels Date 12/6/95

Surveyor's Michigan License No. 30077

FORM APPROVED BY MICHIGAN STATE BOARD OF PROFESSIONAL SURVEYORS, JAN. 28, 1971
REVISED MAY 14, 1975
REVISED JAN., 1983