

SEP 13 1995

COMMISSION

KENT COUNTY REMONUMENTATION

LAND CORNER RECORDATION CERTIFICATE
Filing Requirement of Act 74, Mich. P.A. 1970

For corners in
KENT COUNTY
(County)

Located In:

Corner Code #

1. Public Land Survey	T	<u>8N</u>	R	<u>12W</u>	<u>D-11</u>
	T	_____	R	_____	_____
	T	_____	R	_____	_____
	T	_____	R	_____	_____
2. Property Controlling in Section	S	_____	T	_____	R
	S	_____	T	_____	R
3. Miscellaneous Property in Section	S	_____	T	_____	R
	S	_____	T	_____	R

REG. OF DEEDS

8694

95 AUG 29 AM 10:39

STATE OF MICHIGAN
COUNTY OF KENT
RECEIVED FOR RECORD

Register of Deeds Stamp & File Number

4. Lot No. _____, Recorded Plat _____
5. Private Claims _____

A	B	C	D	E	F	G	H	I	J	K	L	M
2	6	5	4	3	2	1						
3												
4	7	8	9	10	11	12						
5												
6	18	17	16	15	14	13						
7												
8	19	20	21	22	23	24						
9												
10	30	29	28	27	26	25						
11												
12	31	32	33	34	35	36						
13												

I, Kirk Breitels, in a field survey on Aug. 1, 19 95

do hereby certify that under requirements of P.A. 74, Michigan P.A. of 1970, the corner points mentioned in lines 1 and 2 above were in conformance with regulations and rules therefore as required in the current manual of survey instructions of the United States Department of the Interior, Bureau of Land Management or by a decree of a Court of Law and/or that the corner points mentioned in lines 3, 4 and 5 above were in conformance with the rules of the Michigan Board of Professional Surveyors or by a Decree of a Court of Law; established, re-established, monumented, re-monumented, recovered, found as expressed below:

NOTE: Not more than 4 corners, all in the same town and range, may be recorded on this certificate.

A. Description of original monument and accessories and/or subsequent restoration:

D-11	1838	GLO	Whitcomb	Set Post
	1962	Kent Co. Wit.		Sleigh Shoe
	1976	LCRC #934	Bonnema	1" Bar
	1981	LCRC #1419	Shangraw	Sleigh Shoe
	1981	LCRC #2402	Bueche	Set Kent County Monument

The position of this corner was previously approved by the Kent County Remonumentation Peer Group, monumented by John C. Bueche on 11/13/81 and was recorded per LCRC #2402.

B. Description of corner evidence found and/or method applied in restoring or reestablishing corner:

D-11 Found Exxel Capped Iron over remains of broken Kent Co. Mon. per witnesses from above LCRC as set in 1981 by John C. Bueche in place of the Sleigh Shoe he found. Said Sleigh Shoe checks with Kent Co. Wit. and LCRC's #934 & #1419. Set standard Kent Co. (Harrison) Mon. in place of the Exxel Capped Iron and broken Kent Co. Mon.

LCRC #2402

NE cor. garage frame	S40°E	28.56'
NW cor. garage frame	S15°W	24.00'
Nail & KC Remon. tag N. side 10" Pine	S75°E	16.38'
Nail & KC Remon. tag SE side 8" Pine	S40°W	5.00'
Nail & KC Remon. tag N. side 10" Pine	N90°W	33.80'

P.A. 345 1990 KENT COUNTY

PEER APPROVED 8/24/95
CHAIRMAN Harry Huber


C/L blktp. N-S is East 150' ±; C/L blktp. N-S is North 400' ±

The selected location is accepted by me and is generally accepted by professional surveyors as the best available evidence of the position of the original corner.

C. Description of monument for corner and accessories established to perpetuate locating the position of the corner:

D-11 Standard Kent County Monument

NE cor. garage frame	S40°E	28.56'
NW cor. garage frame	S15°W	24.00'
PK Nail is side P. Pole	S90°W	68.80'
Top C/L S'ly end conc. culv.	N30°E	159.10'
C/L blktp. N-S is East 150' ±		
C/L blktp. N-S is North 400' ±		

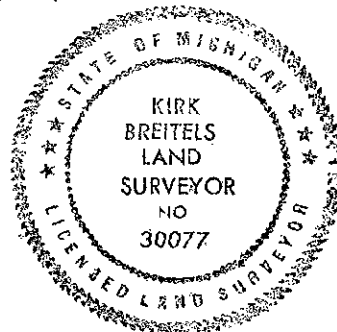

Signed by

Kirk Breitels

Date

8/24/95

Surveyor's Michigan License No.

30077