

Survey & Remonumentation

KENT COUNTY REMONUMENTATION

\$7.00
\$2.00

JAN 24 1996

LAND CORNER RECORDATION CERTIFICATE
Filing Requirement of Act 74, Mich. P.A. 1970

COMMISSION

For corners in
KENT COUNTY
(County)

Located In:

Corner Code #

1. Public Land Survey	T	8N	R	12W	D-12
	T		R		
	T		R		
	T		R		
2. Property Controlling in Section	S		T	R	
	S		T	R	
3. Miscellaneous Property in Section	S		T	R	
	S		T	R	

STATE OF MICHIGAN
COUNTY OF KENT
RECEIVED FOR RECORD

95 DEC 20 AM 8:38

REG. OF DEEDS
8793

Register of Deeds Stamp & File Number

4. Lot No. _____, Recorded Plat _____

5. Private Claims _____

I, Kirk Breitels, in a field survey on Sept. 5, 1995, do hereby certify that under requirements of P.A. 74, Michigan P.A. of 1970, the corner points mentioned in lines 1 and 2 above were in conformance with regulations and rules therefore as required in the current manual of survey instructions of the United States Department of the Interior, Bureau of Land Management or by a decree of a Court of Law and/or that the corner points mentioned in lines 3, 4 and 5 above were in conformance with the rules of the Michigan Board of Professional Surveyors or by a Decree of a Court of Law; established, re-established, monumented, re-monumented, recovered, found as expressed below:

A	B	C	D	E	F	G	H	I	J	K	L	M
2	6	5	4	3	2							
3												
4	7	6	9	10	11	12						
5												
6	18	17	16	15	14	13						
7												
8	19	20	21	22	23	24						
9												
10	30	29	28	27	26	25						
11												
12	31	32	33	34	35	36						
13												

NOTE: Not more than 4 corners, all in the same town and range, may be recorded on this certificate.

A. Description of original monument and accessories and/or subsequent restoration:

- D-12 1837 GLO Not Set
- 1895 Williams & Works Set Stake & Stone at "X" 1/4 lines Kent Co. Wit. Stone
10" Apple NE 48.5'; 10" Apple NW 72.1'
- 1930 Consumers Power Co. Stone "12' E. of 1/4 line, set by T.O. Williams 1895"
- 1983 LCRC #3421 By1 Fd. broken Stone-Set Capped Iron
8" Cherry N60°W 9.15'; 6" Cherry N80°E 6.90'; 12" Apple S45°W 33.75';
12" Apple S30°E 33.80'; 12" Apple S75°W 39.50'

B. Description of corner evidence found and/or method applied in restoring or reestablishing corner:


D-12 Found Capped Rerod (By1) per remaining witnesses from above. Said Rerod is 0.8' S. & 12.3' E. of intersection of 1/4 lines. Said Capped Rerod has been used in surveys by various surveyors over the years.

The Capped Rerod (By1) is accepted by me and is generally accepted by professional surveyors as the best available evidence of the position of the corner.

P.A. 345 1990 KENT COUNTY
PEER APPROVED 9/28/95
CHAIRMAN [Signature]

C. Description of monument for corner and accessories established to perpetuate locating the position of the corner:

- D-12 Set Standard Kent County Monument in place of the Capped Rerod (By1)
- Set Nail & KC Remon. tag N. side 12" Cherry N80°E 6.95'
- Set Nail & KC Remon. tag S. side 15" Cherry N40°W 9.12'
- Set Nail & KC Remon. tag E. side 10" Cherry N15°E 22.64'
- Set Nail & KC Remon. tag N. side 15" Apple S85°W 39.81'
- Set Nail & KC Remon. tag E. side 18" Apple S05°W 48.89'
- Set Nail & KC Remon. tag E. side 18" Apple S40°W 33.60'

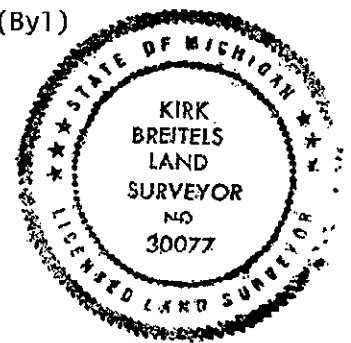

Signed by [Signature]
Surveyor's Michigan License No. 30077

Date 12/6/95